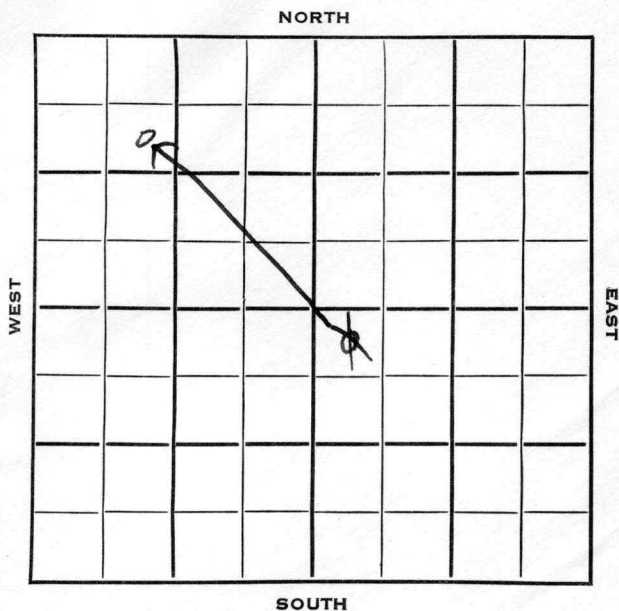


Section 15
16 Township 24 Range 13 EWell No. # 3 HarrisCompany Raymond Smith

Sec. 16 15 Twp. 24 R. 13EWell No. 3 Harris FarmRaymond Smith CompanyL.C. McLaughlin Contractor990
330

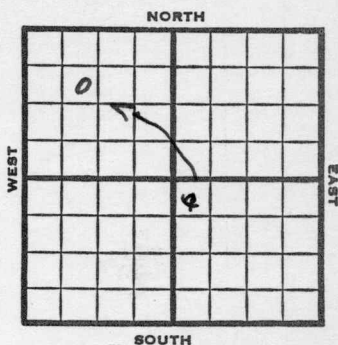
Ft. from N. Line

Ft. from S. Line

Ft. from E. Line

990
330

Ft. from W. Line

~~NW NW SE~~
SE NWNW

1953

Elev. -

REPORT

4/15

MICT

5/27

Spud 4-16-53

Oil Well

TD 1678

10" @ 285

8" @ 995

5" @ 1669

TD 1678

Miss 1668,

500A, CO to 1678

2000A

Comp. 10 bopd

COMPLETED

Kansas

Map No. _____ Sec. 15 Twp. 24 R. 13EWell No. 3 Harris

_____ Raymond Smith _____ Company

CORRECTION

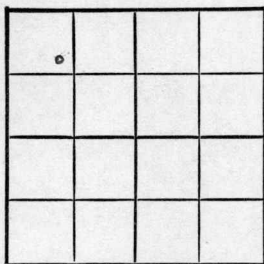
_____ Contractor

SE NW NW

SECTION PLAT990 Ft. from N. Line

_____ Ft. from S. Line

_____ Ft. from E. Line

990 Ft. from W. Line

Greenwood County

Location _____

Rig up _____

Drilling and Remarks:

Reported
16-24-13E
NW NW SE

RECORD

Cased _____ in., _____ ft.

Sand _____

Gas _____

Oil _____

Total Depth _____

PRODUCTION

1st 24 hrs. Nat. _____

1st 24 hrs. after shot _____

Gas _____ Cu. Ft.

Dry Hole _____

Abandoned _____

Date

MAY 13 1953 19

J. G. MCGEHEE

Scout

County Greenwood State Kans.
 Sec. 15 (Blk.) 24 (Sur.) 13E Map No.
 Operator Raymond Smith
 Well No. 3 Farm Harris
 Elev. Location SE NW NW

	0						

COMPLETE

990 Ft. From N Line NW

990 Ft. From W Line Quarter

1st. Report

Completion MAY 27 1953

Remarks

L.C. McLaughlin - Contr.

Spudding Date 4-16-53

Drig. Data Oil well TD 1678
 10" @ 285 8" @ 995 5" @ 1669
 TD 1678 Miss. 1668 500 A CO to 1678
 2000 A Comp. 10 bopd