


Section 36 Township 25 Range 9E

Well No. #19

Company Ind. Terr. Ill. Co.

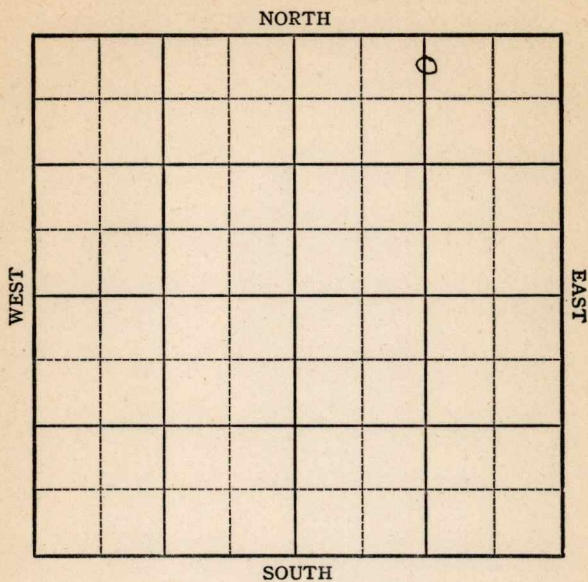

Map No. _____ Sec. 36 Twp. 25 R. 9

Well No. 19 _____ Farm _____


L. T. L. Co. _____ Company

300 Ft. from N. Line

_____ Ft. from S. Line

13 20 Ft. from E. Line

_____ Ft. from W. Line

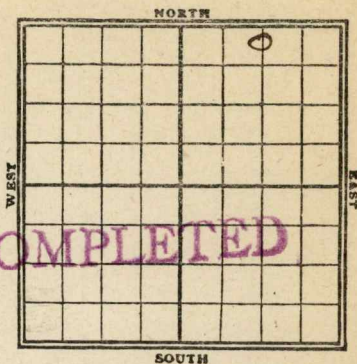

1960
Date

REPORT

FIRST REPORT

3/27

Rig up.

4/9

Moving in tools.

20

740

5/19

1982-2030 shot 149, 25

Map No. 51 Sec. 36 Twp. 25 R. 9Well No. 59

Company _____

Contractor _____

SECTION PLAT

FIRST REPORT

300 Ft. from N. Line

Ft. from S. Line

1370 Ft. from E. Line

Ft. from W. Line

			<u>0</u>

Location _____

Rig up _____

Drilling and Remarks:

RECORD

Cased _____ in., _____ ft.

Sand _____

Gas _____

Oil _____

Total Depth _____

PRODUCTION

1st 24 hrs. Nat. _____

1st 24 hrs. after shot _____

Gas _____ Cu. Ft.

Dry Hole _____

Abandoned _____

Date

3/27 1920 Am 13 Scout

Map No. X51 Sec. 36 Twp. 25 R. 9Well No. 3950

Company _____

Contractor _____

Completion

SECTION PLAT

300 Ft. from N. Line

_____ Ft. from S. Line

1320 Ft. from E. Line

_____ Ft. from W. Line

			0

Location _____

Rig up _____

Drilling and Remarks:

Shot 160 / 125

RECORD

Cased _____ in., _____ ft.

Sand 1982-2030

Gas _____

Oil _____

Total Depth _____

PRODUCTION

1st 24 hrs. Nat. _____

1st 24 hrs. after shot _____

Gas _____ Cu. Ft.

Dry Hole _____

Abandoned _____

Date

5-9-20 AMP Scout