

Section 15 Township 24 Range 13 E
Well No. # 4 Harris
Company R. E. Smith

0

NORTH

WEST

EAST

SOUTH

Greenwood KANSAS

Sec. 15 Twp. 24 R. 13E

Well No. #4 Harris Farm

R. E. Smith Company

McLoflin Contractor
Winterscheid Pool


330 Ft. from N. Line

 Ft. from S. Line

 Ft. from E. Line

330 Ft. from W. Line

NW NW NW

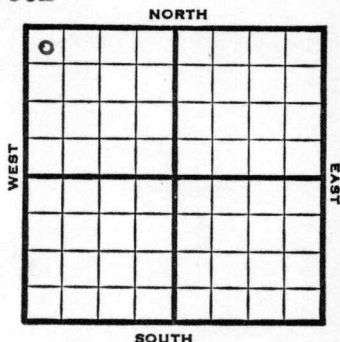

1953 Elev. - REPORT

6/10 Spud 5-31-53
10" @ 306
Drlg. 930'

7/1 Spud 5-31-53
Oil Well
TD 1675
10" @ 306
Miss 1647
TD 1662
5" @ 1662
DD 1675
FU 450' oil, sd-frac
Comp. 30 bopd

(Blk.)
(Twp.)

R. E. Smith

4

Location

2

330 Ft. From

330 Ft. From

JUN 10 1953

Completion

Remarks

McLoflin - Contr.

Spudding Date

Winterscheid Pool

10¹¹ @ 306

drlg. 930

J. G. McGEHEE

County Greenwood State KansasSec. 15 (Blk.
Twp.) 24 (Sur.
Rge.) 13E Map No. _____Operator R. E. SmithWell No. 4 Farm HarrisElev. _____ Location NW NW NW

0							

330 Ft. From N Line NW330 Ft. From W Line Quarter

1st. Report _____

Completion JUL 1 1953Remarks Winterscheid PoolMcLoflin - Contr.Spudding Date 5-31-53Drlg. Data Oil well TD 167510" @ 306 Miss. 1647 TD 16625" @ 1662 DD 1675 FU 450' oil sd-fracComp. 30 bopd