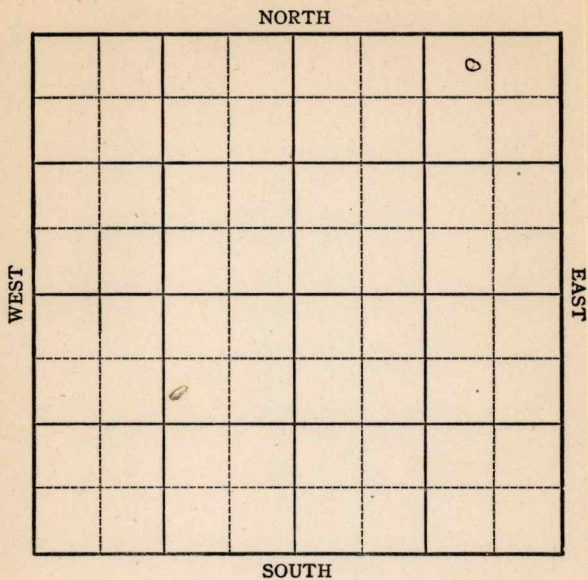


Section 36 Township 25 Range 9EWell No. #20Company Ind. Terr. Ill. Co.

Map No. _____ Sec. 36 Twp. 25 R. 9

Well No. 20 Farm _____

I. J. 9 Oil


Company

300 Ft. from N. Line

_____Ft. from S. Line

_____ Ft. from E. Line

810 Ft from W. Line

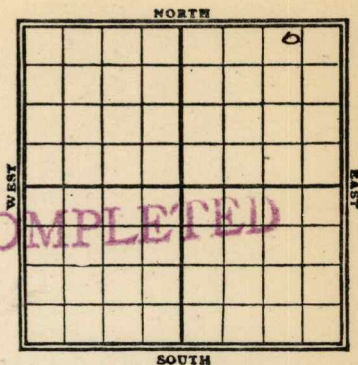

Date _____

REPORT FIRST REPORT

4/2

Rig uh

4/9

Moving in Tools.

20

790

$$\frac{5}{19}$$

2010-81 330/140 Hb.

Map No. 51 Sec. 36 Twp. 25 R. 9Well No. 20

Company

Contractor

FIRST REPORT

SECTION PLAT

300

Ft. from N. Line

Ft. from S. Line

Ft. from E. Line

810

Ft. from W. Line

		0	

Location

Rig up ☒

Drilling and Remarks:

RECORD

Cased _____ in., _____ ft.

Sand _____

Gas _____

Oil _____

Total Depth _____

PRODUCTION

1st 24 hrs. Nat. _____

1st 24 hrs. after shot _____

Gas _____ Cu. Ft.

Dry Hole _____

Abandoned _____

Date

4/2 1920 MB Scout

Map No. X 51 Sec. 36 Twp. 25 R. 9Well No. 20

Company _____

Contractor _____

Completion

SECTION PLAT

300 Ft. from N. Line

_____ Ft. from S. Line

_____ Ft. from E. Line

810 Ft. from W. Line

		0	

Location _____

Rig up _____

Drilling and Remarks:

shot 330 /
146

RECORD

Cased _____ in. _____ ft.

Sand 2010-2081

Gas _____

Oil _____

Total Depth _____

PRODUCTION

1st 24 hrs. Nat. _____

1st 24 hrs. after shot _____

Gas _____ Cu. Ft.

Dry Hole _____

Abandoned _____

Date

5/19 1912

MB

Scout