


Map No. **KANSAS** Sec. 6 Twp. 25 R. 9

Well No. 2 - Olsen Farm
J. B. Murphy Company
NORTH

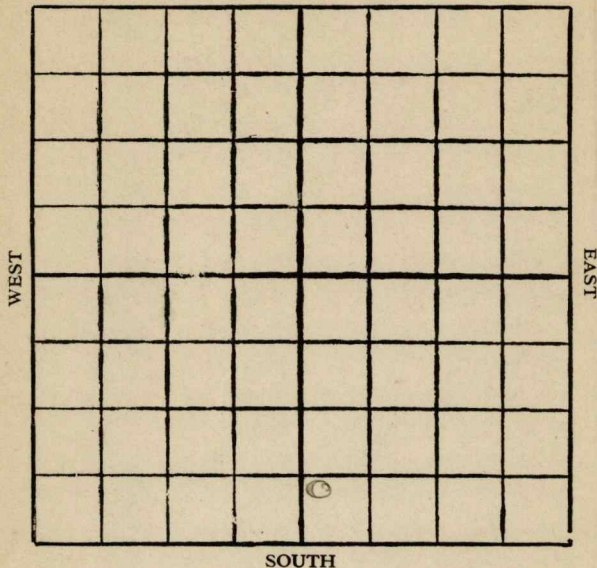

Location

Drilling Remarks

Rig Up.....

Drilling Remarks

RECORD

Cased.....in.ft.

Sand

Gas

Oil _____

Total Depth.....

PRODUCTION

1st 24 hrs. Nat.

1st 24 hrs. after shot.....

Gas..... cu. ft.

Dry Hole

Abandoned

KANSASMap No. _____ Sec. 6 Twp. 25 R. 9Well No. 2 - Olsen Farm _____J. B. Murphy Company

NORTH

_____ Ft. from N. Line

636 Ft. from S. Line

_____ Ft. from E. Line

220 Ft. from W. Line1928

WEST

EAST

SOUTH

Date

REPORT

3/8	R. O. G.
3/16	Timbers
3/22	Drilg 680
3/29	" 1190
4/5	" 1805
4/12	" 1950
4/19	2087-2129 T.D. 2129
	Dril 2105
	60/150 hbb

15 KANSAS

Map No. _____ Sec. 6 Twp. 15 R. 9Well No. 2 OlsenJ. B. Murphy _____ Company

_____ Contractor

FIRST REPORTS

SECTION PLAT

_____ Ft. from N. Line

636 _____ Ft. from S. Line

_____ Ft. from E. Line

220 _____ Ft. from W. LineLocation R.O. 8

Rig up _____

Drilling and Remarks:

Formerly Lissen

RECORD

Cased _____ in., _____ ft.

Sand _____

Gas _____

Oil _____

Total Depth _____

PRODUCTION

1st 24 hrs. Nat. _____

1st 24 hrs. after shot _____

Gas _____ Cu. Ft.

Dry Hole _____

Abandoned _____

Date

MAR 8 1928

CHAS. L. SHERWOOD

192

Scout

15 **KANSAS** Sec. 6 Twp. 25 R. 9
 Map No. _____
 Well No. 2 Olsen
 J. B. Murphy _____ Company
 _____ Contractor

COMPLETED**SECTION PLAT**

_____ Ft. from N. Line

636 _____ Ft. from S. Line

_____ Ft. from E. Line

270 _____ Ft. from W. Line

		0	

Location _____

Rig up _____

Drilling and Remarks:

Oil 2105'

607150 Bl

RECORD

Cased _____ in., _____ ft.

Sand 2087-2129

Gas _____

Oil _____

Total Depth 2129

PRODUCTION

1st 24 hrs. Nat. _____

1st 24 hrs. after shot _____

Gas _____ Cu. Ft.

Dry Hole _____

Abandoned _____

Date

APR 19 1928

192

CHAS. L. SHERWOOD

Scout