


Map No. Russell **KANSAS** Sec. 32 Twp. 13 R. 15^W
 Well No. 16- Barter Farm
Keys Bros Company

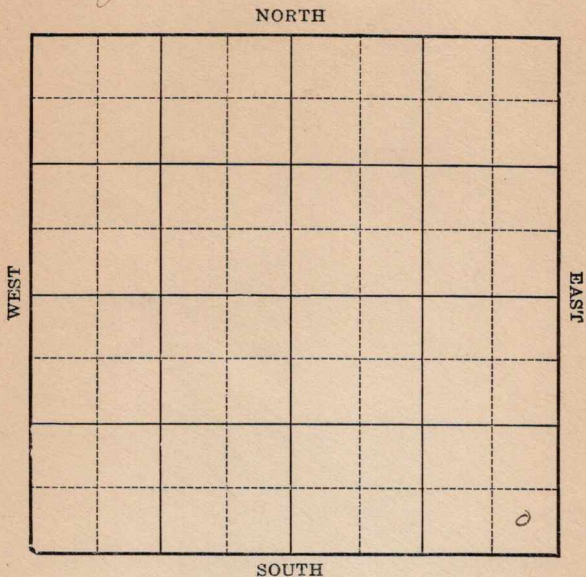

Location _____
 Drilling Remarks _____

Rig Up _____
 Drilling Remarks _____

RECORD


Cased _____ in. _____ ft.
 Sand _____
 Gas _____
 Oil _____
 Total Depth _____

PRODUCTION

1st 24 hrs. Nat. _____
 1st 24 hrs. after shot _____
 Gas _____ cu. ft.
 Dry Hole _____
 Abandoned _____

Map No. KANSAS Sec. 32 Twp. 13 R. 15^w
 Well No. 16 - Parter Farm
Kays Bros Company

NORTH

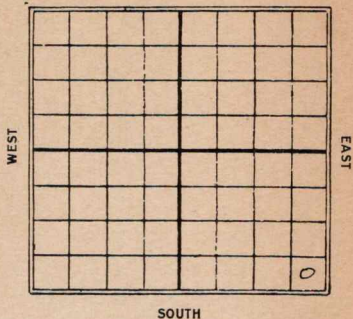

Ft. from N. Line
330 Ft. from S. Line
330 Ft. from E. Line
1930 Ft. from W. Line

Date	REPORT
11/25	ROS
12/3	—
12/10	—
12/17	—
12/23	—
12/30	—
1/31	—
1/7	—
1/14	Bldg reg
1/21	—
1/28	Reg
2/4	4/22 —
2/11	— 4/29 - Regn. up
2/18	— 5/6 —
2/25	— 5/13 —
3/4	— 5/20 —
3/11	— 5/27 —
3/18	— 6/3 - R.A. + S.D
3/25	— 6/10 — 7/8 —
4/1	— 6/17 — 7/15 —
4/8	— 6/24 — 7/22 —
4/15	— 7/1 — 7/29 —

8/5 - R.N. & S.D. 751212

8/12 — 2/26 - abandon
location

8/19 —

8/26 —

9/2 —

9/9 —

9/16 —

9/23 —

9/30 —

10/7 —

10/14 —

10/21 —

10/28 —

11/3 —

11/10 —

11/18 —

11/24 —

12/2 —

12/9 —

12/16 —

12/22 —

12/30 —

1932

1/6 —

1/13 —

1/20 —

1/27 —

2/3 —

2/10 —

2/17 —

Map No. **KANSAS** Sec. 32 Twp. 13 R. 15W

Well No. 16 Baxter

Key Bess Company

Contractor

SECTION PLAT

Ft. from N. Line

830 Ft. from S. Line

830 Ft. from E. Line

Ft. from W. Line

FIRST REPORTS

Location

Rig up

Drilling and Remarks:

ROG

RECORD

Cased in, ft.

Sand

Gas

Oil

Total Depth

PRODUCTION

1st 24 hrs. Nat.

1st 24 hrs. after shot

Gas Cu. Ft.

Dry Hole

Abandoned

Date

NOV 25 1930

S. J. LEWIS

Scout

Russell

72

KANSAS

Map No. _____ Sec. 32 Twp. 13 R. 15Well No. 16 BarterKeys Bros Company

Contractor

COMPLETE

SECTION PLAT

_____ Ft. from N. Line

330 Ft. from S. Line330 Ft. from E. Line

_____ Ft. from W. Line

ABANDONED

Location _____

Rig up _____

Drilling and Remarks:

Rig abandoned

RECORD

Cased _____ in., _____ ft.

Sand _____

Gas _____

Oil _____

Total Depth _____

PRODUCTION

1st 24 hrs. Nat. _____

1st 24 hrs. after shot _____

Gas _____ Cu. Ft.

Dry Hole _____

Abandoned Rig

Date

FEB 26 1932

19

CHAS. L. SHERWOOD

Scout