


Section 15 Township 24 Range 13E

Well No. 2 Harris

Company R. E. Smith

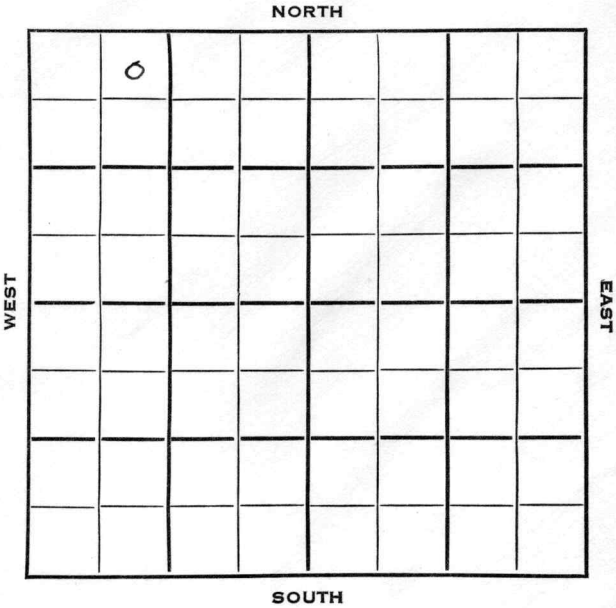


Greenwood

KANSAS

Sec. 15 Twp. 24 R. 13EWell No. #2 Harris FarmR. E. Smith CompanyM. C. McLaughlin Contractor330 Ft. from N. Line Ft. from S. Line Ft. from E. Line990 Ft. from W. Line

NE NW NW

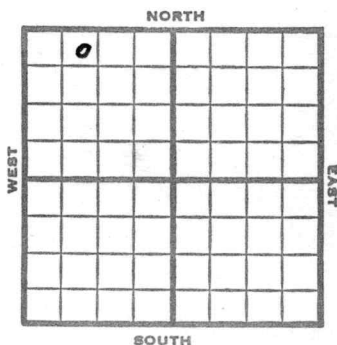

1953

Elev. -

REPORT

1/14 Spud 1-12-53

2/18 Spud 1-12-53 Oil well TD 1672'
 Miss 1646' TD 1665 4" @ 1661
 DD 1672
 Comp. 35 BOPD

COMPLETED

County Greenwood State Kansas
 Sec. 15 (Blk.) 24 (Sur.) 13E Map No. _____
 Operator R. E. Smith
 Well No. 2 Farm Harris
 Elev. _____ Location NE NW NW

0							

330 Ft. From N Line NW
990 Ft. From W Line Quarter
 1st. Report JAN 14 1953

Completion _____

Remarks _____

M.C. McLaughlin - Contr.

Spudding Date 1-12-53

Drlg. Data _____

County Greenwood State KansasSec. 15 (Blk.
Twp.) 24 (Sur.
Rge.) 13E Map No. _____Operator R. E. SmithWell No. 2 Farm HarrisElev. _____ Location NE NW NW

	o						

330 Ft. From N Line NW990 Ft. From W Line Quarter1st. ReportCompletion FEB 18 1953RemarksM.C. McLaughlin - Contr.Spudding Date 1-12-53Drig. Data Oil well TD 1672Miss. 1646 TD 1665 4" @ 1661 DD 1672Comp. 35 bopd

J. G. McGEHEE