KANSAS


FORM 51 5M 2-38 TPCO.

Russell

Section 29 Township 13 Range 14-W

Well No. 1 Miller "B"

Company Lauck & Moncrief

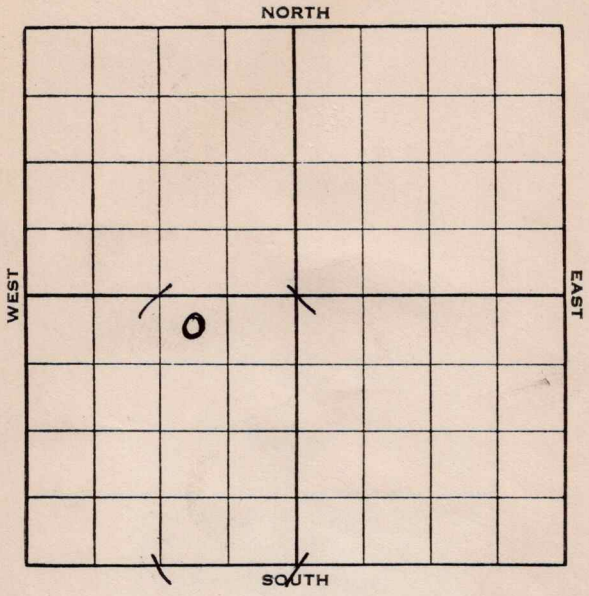

FORM 252-A 5M 1-38 KANSAS Russell

Sec. 29 Twp. 13 R. 14-W

Well No. #1 Miller "B" Farm


Lauck & Moncrief Company

330 Ft. from N. Line

Ft. from S. Line

990 Ft. from E. Line

Ft. from W. Line

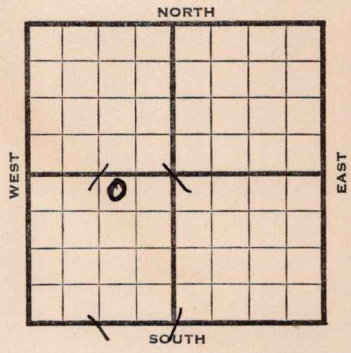

Elev. 1852

1938	REPORT
8/24	13" - 62'. WOC.
9/2	Anhy 902'. Dlg. 2255'.
9/9	K. C. 3019'. Dlg. 3227'.
9/16	Arb. 3296'. 7" - 3296'.
	T. D. 3305'. S. O. 1000 acid.
9/21	7" at 3296'.
	Arb. 3296'.
	T. D. 3312'.
	1000 acid.
	Potential 687 bbls.
	Cut 10% water.
	COMPLETED

Form 26—1M Bks.—2-29

Russell KANSAS

Map No. 72 Sec. 29 Twp. 13 R. 14W

Well No. 1 Miller "B"

Lauck & Moncrief Company

Contractor

FIRST REPORT

NW NE SW


330 Ft. from N. Line

_____ Ft. from S. Line

990 Ft. from E. Line

_____ Ft. from W. Line

SECTION PLAT

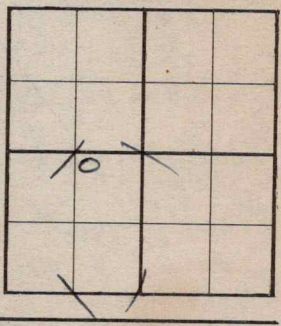

Location _____

Rig up _____

Drilling and Remarks:

13" - 62

WOC

RECORD

Cased _____ in., _____ ft.

Sand _____

Gas _____

Oil _____

Total Depth _____

PRODUCTION

1st 24 hrs. Nat. _____

1st 24 hrs. after shot _____

Gas _____ Cu. Ft.

Dry Hole _____

Abandoned _____

Date

AUG 24 1938 19____

H. D. Hatfield Scout

Form 26—1M Bks.—2-29 Russell KANSAS

Map No. 72 Sec. 29 Twp. 13 R. 14W

Well No. 1 Miller "B"

Lauck & Moncrief Company

Contractor

NW NE SW


330 Ft. from N. Line

Ft. from S. Line

990 Ft. from E. Line

Ft. from W. Line

SECTION PLAT

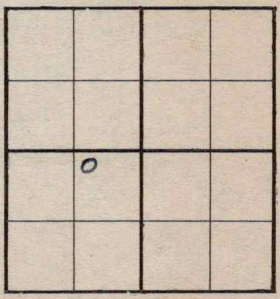

Location

Rig up

Drilling and Remarks:

1000 acid
Pot 687
cut 10 70 WTR

RECORD

Cased 7 in., 3296 ft.

~~Sand~~ Arb 3296

Gas

Oil

Total Depth 3312

PRODUCTION

1st 24 hrs. Nat.

1st 24 hrs. after shot

Gas Cu. Ft.

Dry Hole

Abandoned

Date

9-21-38 19 H. D. Hatfield Scout