

Map No. **KANSAS** Sec. 6 Twp. 25 R. 9


Well No. 1-Claycomb Farm
W. H. Nelson et al Company

..... Ft. from N. Line

330 Ft. from S. Line

..... Ft. from E. Line

990 Ft. from W. Line

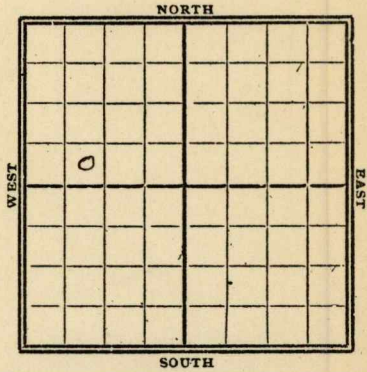

1928

Date

REPORT

Date	REPORT
11/28	Location
12/5	Rig up machine
12/12	D. H. g 650'
12/19	S.D. 1020'
12/26	S.D. 1260'
1929	
1/2	drlg 1325'
1/9	set 6" - 2175' drlg 2206'
1/16	
1/23	720 sand T.D. 2372' dry & abandoned

Sherwood

K15 KANSAS

6 SEC. 75 TWP. 9 R.

MAP NO.

SEC.

TWP.

R.

WELL No. 1

clay comb

W. H. Nelson et al COMPANY

CONTRACTOR

FIRST REPORTS

SECTION PLAT

_____ FT. FROM N. LINE

330

_____ FT. FROM S. LINE

_____ FT. FROM E. LINE

990

_____ FT. FROM W. LINE

0			

LOCATION

RIG UP _____

DRILLING AND REMARKS:

RECORD

CASED _____ IN., _____ FT.

SAND _____

GAS _____

OIL _____

TOTAL DEPTH _____

PRODUCTION

1ST 24 HRS. NAT. _____

1ST 24 HRS. AFTER SHOT _____

GAS _____ CU. FT.

DRY HOLE _____

ABANDONED _____

DATE NOV 28 1928

CHAS. L. SHERWOOD

Sherwood

Map No. **KANSAS** Sec. *6* Twp. *25* R. *9*

Well No. *K15 / clay comb*

W. H. Nelson et al Company

Contractor

COMPLETE

SECTION PLAT

..... Ft. from N. Line

330 Ft. from S. Line

..... Ft. from E. Line

990 Ft. from W. Line

	<i>o</i>		

ABANDONED

Location.....

Rig up.....

Drilling and Remarks:

No sand

DDG 2372'

RECORD

Cased..... in., ft.

Sand.....

Gas.....

Oil.....

Total Depth *2372'*

PRODUCTION

1st 24 hrs. Nat.....

1st 24 hrs. after shot.....

Gas..... Cu. Ft.

Dry Hole

Abandoned

Date

JAN 23 1929

192.....

CHAS. L. SHERWOOD

Scout