


Map No. **KANSAS** Sec. 6 Twp. 25 R. 9

Well No. 3-Olsen Farm
J. B. Murphy Company

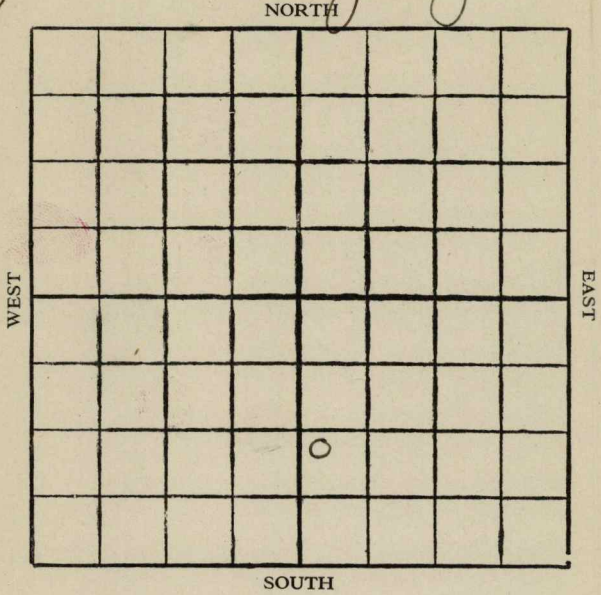

Location

Drilling Remarks

.....

.....

Rig Up

Drilling Remarks

.....

.....

RECORD

Cased in. ft.

Sand

Gas

Oil

Total Depth

PRODUCTION

1st 24 hrs. Nat.

1st 24 hrs. after shot

Gas cu. ft.

Dry Hole

Abandoned

KANSAS

Map No. _____ Sec. 6 Twp. 25 R 9 E


Well No. 3 - Olsen Farm _____
J. B. Murphy Company _____

_____ Ft. from N. Line

1065 Ft. from S. Line

_____ Ft. from E. Line

200 Ft. from W. Line

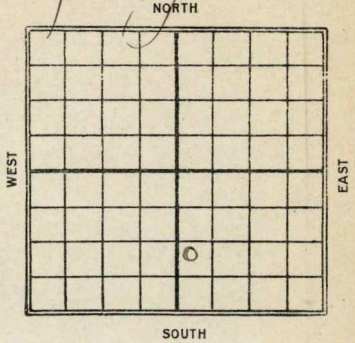

1928

Date

REPORT

Date	REPORT
<u>5/10</u>	<u>Rig up</u>
<u>5/18</u>	<u>Drilg 700</u>
<u>5/24</u>	<u>" 1300</u>
<u>5/31</u>	<u>" 2000</u>
<u>6/7</u>	<u>2090-2120 T.D. 2120</u>
	<u>sdv shale 2070-90</u>
	<u>60/200 bbls</u>

G. M. Wood

15 **KANSAS** SEC. 6 TWP. 25 R. 9^E

WELL No. 3 *alden*

J. B. Murphy COMPANY _____ CONTRACTOR _____

FIRST REPORTS

SECTION PLAT

_____ FT. FROM N. LINE
1065 FT. FROM S. LINE
_____ FT. FROM E. LINE
200 FT. FROM W. LINE

		0	

LOCATION _____
RIG UP
DRILLING AND REMARKS:

RECORD

CASED _____ IN., _____ FT.
SAND _____
GAS _____
OIL _____
TOTAL DEPTH _____

PRODUCTION

1ST 24 HRS. NAT. _____
1ST 24 HRS. AFTER SHOT _____
GAS _____ CU. FT.
DRY HOLE _____
ABANDONED _____

DATE

MAY 10 1928

CHAS. L. SHERWOOD

Sherwood

MAP No. 15 **KANSAS** SEC. 6 TWP. 25 R. 9

WELL No. 3 *el sen*
J.B. Murphy COMPANY _____
CONTRACTOR _____

COMPLETED

SECTION PLAT

		0	

_____ FT. FROM N. LINE
1065 FT. FROM S. LINE
_____ FT. FROM E. LINE
200 FT. FROM W. LINE

LOCATION _____

RIG UP _____

DRILLING AND REMARKS:

Sdy shale 2070-90

log 200 *ffs*

RECORD

CASED _____ IN. _____ FT.
SAND 2090-2120
GAS _____
OIL _____
TOTAL DEPTH 2120

PRODUCTION

1ST 24 HRS. NAT. _____
1ST 24 HRS. AFTER SHOT _____
GAS _____ CU. FT.
DRY HOLE _____
ABANDONED _____

DATE

JUN 7 1928

CHAS. L. SHERWOOD

192

SCOUT