

Russell

KANSAS

Section 35 Township 13 Range 15WWell No. #1 Dillner SWDCompany Fred Haynes

NORTH

							0

WEST

EAST

SOUTH

Russell

KANSAS

Sec. 35 Twp. 13 R. 15 W

Well No. # 1 Dillner SWD Farm

Fred Haynes Company

Haynes Contractor

Gorham Pool


990 Ft. from N. Line

_____ Ft. from S. Line

440 Ft. from E. Line

_____ Ft. from W. Line

NORTH

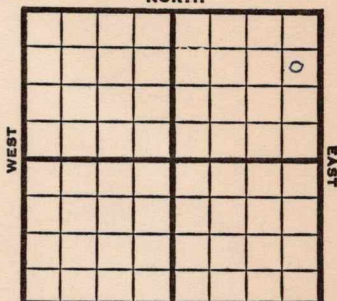

SOUTH

SE NE NE

1951

Elev. 1884 REPORT

5/9

R U R

5/29

Location Aband.

ABANDONED

County **Russell** State **Kansas**Sec. **35** (Blk. Twp.) **13** (Sur. Rge.) **15W** Map No.Operator **Fred Haynes**Well No. **1** Farm **Dillner** **SWD**Elev. Location **SE NE NE**

FIRST REPORT

990 Ft. From **N** Line **NE****440** Ft. From **E** Line **Quarter**1st. Report **MAY 9 1951**

Completion


Remarks

Haynes - Contr.

Spudding Date

Drlg. Data **Gorham Pool****R U R****J. E. TYRA**

County Russell State Kansas
 Sec. 35 (Blk.) 13 (Sur.) 15W Map No.
 Operator Fred Haynes
 Well No. 1 Farm Dillner SWD
 Elev. 1884 Location SE NE NE

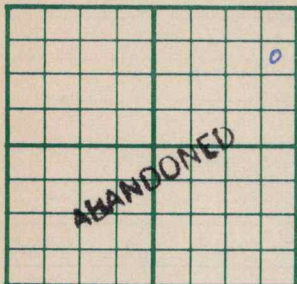

990 Ft. From N Line NE
440 Ft. From E Line Quarter

1st. Report

Completion MAY 29 1951

Remarks Gorham Pool

Haynes - Contr.

Spudding Date

Drig. Data

Location abd.

J. E. TYRA