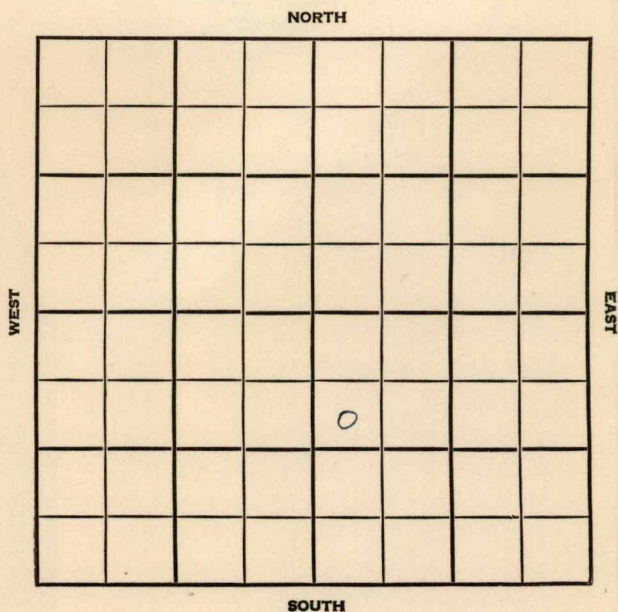


Section 6 Township 25S Range 9EWell No. #5 OlsenCompany E. W. Sauder

SEC.

6

TWP.

25

R.

9E

WELL NO.

#5 Olsen

FARM

COMPANY

E.W. Sauder

CONTRACTOR

Co.

Wilkerson


_____ FT. FROM N. LINE

_____ FT. FROM S. LINE

_____ FT. FROM E. LINE

_____ FT. FROM W. LINE

SW NW SE

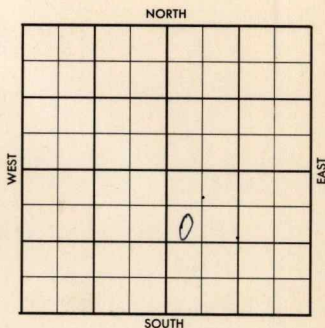

ELEVATION

1956

REPORT

8-29

Comm. 8-22-56
Drlg.

Co.

Lse.

No.

Sec.

T.

R.

County Greenwood Elev. _____
 Sec. 6 Twp. 25S Rge. 9E
 Company E. W. Sauder
 Farm Name Olsen No. 5

TOPS	DEPTH	LOG	DATUM	Loc. in Sec.
Anh.				SW NW SE
TP.				
H.				
Tr.				
Dg. <u>CAHIE</u>	<u>2096</u>			
BL.				
L.				Geol.
K.C.				Contr.
B.K.C.				
Ce.				Co.
C.				
M.				Pool
M.				<u>Wilkerson</u>
K.				
Mz.				
Mo.				
V.				
S.				
S.				
A.				
R.				
Pe.				
G.				
TD	<u>2107</u>			

COMPLETE

OCT 24 '56

Date Comm. 8-22-56

Drilg. SEP 5 '56 ✓ SEP 12 '56 7" @ 1440

ID 1990 SEP 19 '56 4 1/2 @ 2097

PB 2104 SEP 26 '56 CO OCT 3 '56 ✓

OCT 10 '56 CO DD 2117 Frac & WH

OCT 17 '56 P. 10. OCT 24 '56 P. 10

Bopd + 50 Bwpd.

County Greenwood Elev. _____
Sec. 6 Twp. 25S Rge. 9E
Company E. W. Sauder
Farm Name Olsen No. 5

TOPS	DEPTH	LOG	DATUM	Loc. in Sec.
Anh.				SW NW SE
TP.				
H.				
Tr.				
Dg.				
BL.				
L.				Geol.
K.C.				
B.K.C.				Contr.
Ce.				
C.				Co.
M.				
M.				Pool
K.				
Mz.				Wilkerson
Me.				
V.				
S.				
S.				
A				
R.				
PE.				
G.				
TD.				

Lse
No.

AUG 29 '56
FIRST REPORT

Date Comm. 8-22-56

~~Dr 1g.~~