

Map No. Kansas Sec. 16 Twp. 24 R. 13
Well No. 3 Blackwell Farm
Prairie O. & G. Company

Well No. 3 Blackwell Farm
Prairie O. & G. Company

A 6x6 grid of squares. The grid is defined by solid lines. Dashed lines run horizontally and vertically through the center of each square, creating a 12x12 grid of smaller squares. A small circle is drawn in the center of the grid, specifically in the intersection of the 4th vertical dashed line from the left and the 4th horizontal dashed line from the top. The word "WEST" is written vertically on the left side, "EAST" on the right side, and "SOUTH" at the bottom center.

WEST

EAST

SOUTH

Location _____

Drilling Remarks

Rig Up

Drilling Remarks

RECORD

Cased _____ in. _____ ft.

Sand

Gas

Oil

Total Depth

PRODUCTION

1st 24 hrs. Nat. _____

1st 24 hrs. after shot -----

Gas _____ cu. ft.

Dry Hole


Abandoned

Greenwood Co

Map No. Kansas Sec. 16 Twp. 24 R 13Well No. 3 Blackwell Farm
Prairie O. & G. Company250 Ft. from N. Line

_____ Ft. from S. Line

_____ Ft. from E. Line

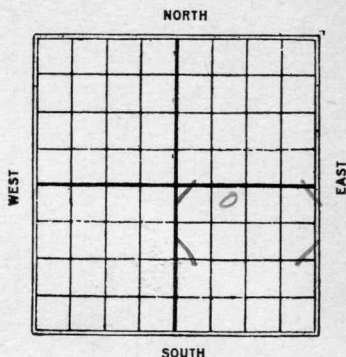700 Ft. from W. Line

Date

REPORT

192512/10 Location12/17 machine12/23 _____12/31 _____19261/8 Spudding1/14 Dlg 200'1/20 Running 10" 740'1/27 shut down 1100'2/4 Dlg 1120'2/10 Tap line 1615' Sand 1625.1654' shot 100 gts, Est
70 bbls.2/17 Sand 1625-1654


100 gts 60 Bbls

Form 26—1M Bks.—3-23—11959. *Shenwood Co*
 Map No. *KANSAS* Sec. *16* Twp. *24* R. *13*
 Well No. *3 Blackwell*
Pratt Oil & Gas Co Company

Contractor

SECTION PLAT

250 Ft. from N. Line
 _____ Ft. from S. Line
 _____ Ft. from E. Line
700 Ft. from W. Line

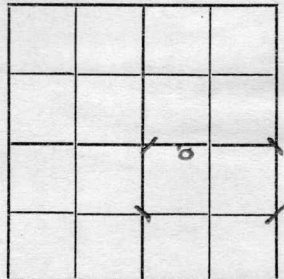

FIRST REPORTS

Location ☒ _____
 Rig up _____
 Drilling and Remarks:

RECORD

Cased _____ in., _____ ft.
 Sand _____
 Gas _____
 Oil _____
 Total Depth _____

PRODUCTION

1st 24 hrs. Nat. _____
 1st 24 hrs. after shot _____
 Gas _____ Cu. Ft.
 Dry Hole _____
 Abandoned _____

Date DEC 10 1925
 _____ 192 _____ CHAS. L. SHERWOOD
 _____ Scout

Map No. *16* KANSAS Sec. *16* Twp. *24* R. *13*

Well No. *3* *Blackwood*
Prarie oil & gas Co. Company

Contractor

COMPLETED

SECTION PLAT

250

Ft. from N. Line

Ft. from S. Line

Ft. from E. Line

700

Ft. from W. Line

		<i>o</i>	

Location

Rig up

Drilling and Remarks:

Tap lens 1615'

100y 60 ft.

RECORD

Cased *1625-1654* in., ft.

Sand

Gas

Oil

Total Depth *1654*

PRODUCTION

1st 24 hrs. Nat.

1st 24 hrs. after shot

Gas Cu. Ft.

Dry Hole

Abandoned

Date

FEB 17 1926

192

CHAS. L. SHERWOOD

Scout