


Map No. **KANSAS** Sec. 12 Twp. 13 R. 16^W
 Well No. 1-Burns Farm
Ashby Company

NORTH

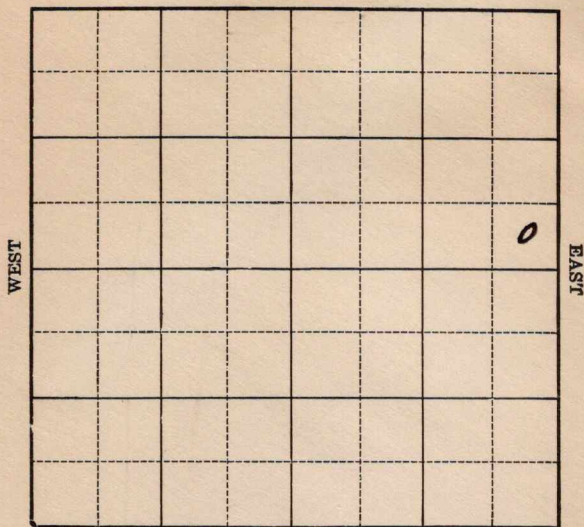

Location _____

Drilling Remarks _____

Rig Up _____

Drilling Remarks _____

RECORD

Cased _____ in. _____ ft.

Sand _____

Gas _____

Oil _____

Total Depth _____

PRODUCTION

1st 24 hrs. Nat. _____

1st 24 hrs. after shot _____

Gas _____ cu. ft.

Dry Hole _____

Abandoned _____

Ellis

Map No. KANSAS Sec. 12 Twp. 13 R. 16 W


Well No. 1- Burns Farm
Ashby Company

 Ft. from N. Line

330 Ft. from S. Line

330 Ft. from E. Line

 Ft. from W. Line

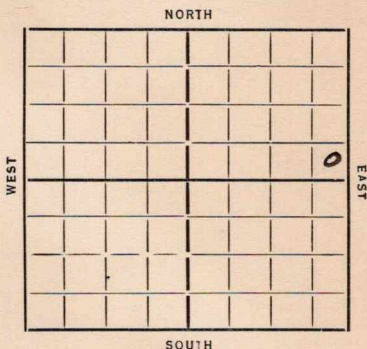

Date 1935

REPORT

<u>3/6</u>	<u>Rgn</u>	<u>12" 345</u>
<u>3/14</u>		<u>10" 657</u>
<u>3/21</u>	<u>Alg 1050</u>	<u>8" 118</u>
<u>3/28</u>	<u>" 1700</u>	<u>anhydrite 1002</u>
<u>4/4</u>	<u>" 2045</u>	
<u>4/11</u>	<u>" 2460</u>	<u>6" 2270</u>
<u>4/18</u>	<u>" 2588</u>	<u>6" 2500</u>
<u>4/26</u>	<u>6" 2594</u>	<u>HFW 2625-32</u>
	<u>seg 2668</u>	
<u>5/2</u>	<u>Alg 2808</u>	
<u>5/9</u>	<u>" 2900</u>	<u>6" 2814</u>
<u>5/16</u>	<u>Or. 3113</u>	<u>S. O. 3140-43</u>
	<u>HFW 3190-95</u>	<u>WR 5" 3025 3205</u>
<u>5/23</u>	<u>Alg 3220</u>	<u>5" 3202</u>
<u>5/29</u>		
<u>6/5</u>	<u>Orwell 3113</u>	<u>T. 7 3280</u>
	<u>HFW</u>	<u>Dr. A.</u>

ABANDONED

Map No. 71 Sec. 12 Twp. 13 R. 16WWell No. 1- BurnsAsky Company

Contractor

FIRST REPORTS

SECTION PLAT

Ft. from N. Line

330 Ft. from S. Line330 Ft. from E. Line

Ft. from W. Line

			0

KANSAS

Location

Rig up

Drilling and Remarks:

leg w

RECORD

Cased in., ft.

Sand

Gas

Oil

Total Depth

PRODUCTION

1st 24 hrs. Nat.

1st 24 hrs. after shot

Gas Cu. Ft.

Dry Hole

Abandoned

Date

ORVAL MANNSCHRECK

3-6-35 192

Scout

Map No. 71 Sec. 12 Twp. 13 R. 16W

Well No. 1-Burns

Ashby Company

Contractor

ABANDONED

SECTION PLAT

			0

Ft. from N. Line

330 Ft. from S. Line

330 Ft. from E. Line

Ft. from W. Line

Location

Rig up

Drilling and Remarks:

H F W

NO + H

RECORD

Cased in. ft.

Sand Orvald 3113

Gas

Oil

Total Depth 3280

PRODUCTION

1st 24 hrs. Nat.

1st 24 hrs. after shot

Gas Cu. Ft.

Dry Hole

Abandoned

Date

ORVAL MANNSCHRECK

6-5-35 192 Scout