


Map No. Kansas Sec. 16 Twp. 24 R. 13
 Well No. 4-Blackwell Farm
Rhodes-Abell Company

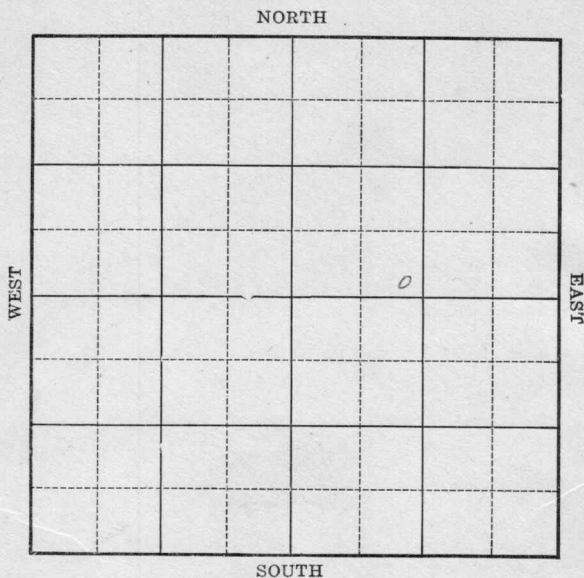

Location _____

Drilling Remarks _____

Rig Up _____

Drilling Remarks _____

RECORD

Cased _____ in. _____ ft.
 Sand _____
 Gas _____
 Oil _____
 Total Depth _____

PRODUCTION

1st 24 hrs. Nat. _____
 1st 24 hrs. after shot _____
 Gas _____ cu. ft.
 Dry Hole _____
 Abandoned _____


Map No. Kansas Sec. 16 Twp. 24 R. 13 Greenwood
 Well No. 4 Blackwell Farm
Rhodes & Abell Company

Ft. from N. Line

250 Ft. from S. Line

Ft. from E. Line

760 Ft. from W. Line

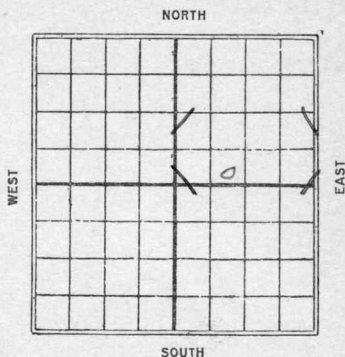

Date

REPORT

1926
 4/7 Rigging up
 4/14

4/21 Surf 425

4/30 " 850

5/8 " 1320

5/19 Sand 1628-1656. J.D.

Top lime 1622'

20/15 bbls.

Norman KANSAS

Map No. _____ Sec. *16* Twp. *24* R. *13*

Well No. *4 Blackwell*

Rhodes & Shell Company

Contractor

FIRST REPORTS

_____ Ft. from N. Line

250 _____ Ft. from S. Line

_____ Ft. from E. Line

760 _____ Ft. from W. Line

SECTION PLAT

Location _____

Rig up _____

Drilling and Remarks:

Rigging up

RECORD

Cased _____ in., _____ ft.

Sand _____

Gas _____

Oil _____

Total Depth _____

PRODUCTION

1st 24 hrs. Nat. _____

1st 24 hrs. after shot _____

Gas _____ Cu. Ft.

Dry Hole _____

Abandoned _____

Date

APR 7 1926

CHAS. L. SHERWOOD

192

Scout

no map
 Map No. **KANSAS** Sec. **16** Twp. **24** R. **13**
 Well No. **4. Backwell**

Rhodes & Abell Company

Contractor

COMPLETED

SECTION PLAT

Ft. from N. Line

250

Ft. from S. Line

Ft. from E. Line

760

Ft. from W. Line

		/	
		o	

Location

Rig up

Drilling and Remarks:

Tap line 1622'

809 15 BS.

RECORD

Cased 1628 in., 1656 ft.

Sand 1628-1656

Gas

Oil

Total Depth 1656'

PRODUCTION

1st 24 hrs. Nat.

1st 24 hrs. after shot.

Gas Cu. Ft.

Dry Hole

Abandoned

Date

MAY 12 1926

192

CHAS. L. SHERWOOD

Scout