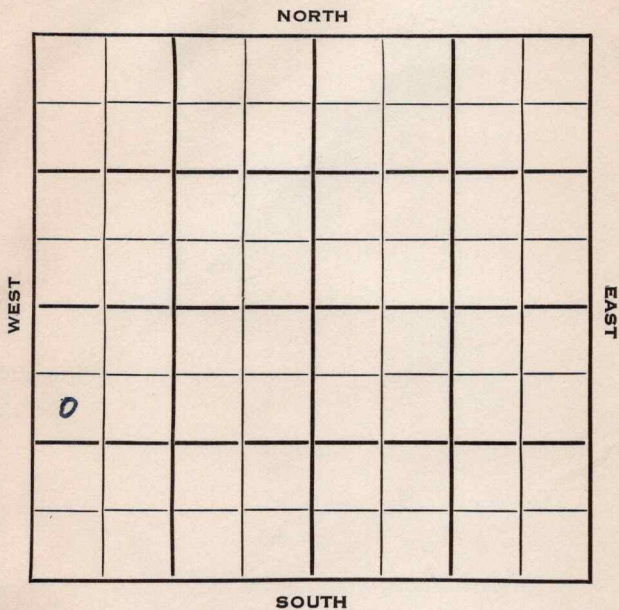


Section 14 Township 20 Range 12WWell No. 1 Buckbee "C"Company Texas Company

|                        |      |       |
|------------------------|------|-------|
| SEC.                   | TWP. | R.    |
| 14                     | 20   | 12W ✓ |
| WELL NO.               |      |       |
| 1 Buckbee "C" (Lizzie) |      |       |
| COMPANY                |      | FARM  |
| Texas Company          |      |       |
| CONTRACTOR             |      |       |


Anschutz Drlg.  
SW Buckbee Pool

990 Ft. from N. Line

Ft. from S. Line

Ft. from E. Line

330 Ft. from W. Line

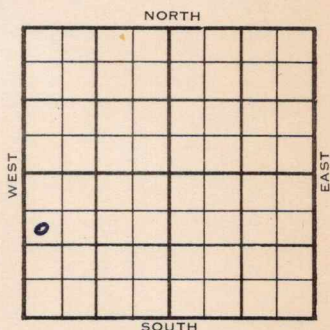

SW NW SW

|      | ELEVATION   | REPORT |
|------|---|--------|
| 1954 | 1814'   |        |
| 3/3  | Spud 2-28-54<br>10" @ 611'<br>Drlg. 1060'   |        |
| 3/10 | Heeb 3003', Br li 3125', Lans 3143'<br>Drlg. 3351'   |        |
| 3/17 | Arb. 3378'<br>RTD 3382'<br>7" @ 3381' log<br>CO 3382' NS<br>DD 3427' 1 qt. oph   |        |
| 3/24 | Spud 2-28-54 D & A TD 3485<br>10" @ 611' Heeb 3003 Br. lime 3125<br>Lans. 3143 Arb. 3378 TD 3382<br>7" @ 3381 CO to 3382 DD 3427<br>1 qt. OPH 500 A 16 GO 185 GW 11 hr.<br>DD 3451 DD 3482 B/wtr. DD 3485<br>10 GO 4 BWPH 3 hr. PB 3346<br>16/3292-98 1000 A wtr. 54/3236-42<br>1000 A 8 BWPH 4 hr. PB 3225<br>12/3212-16 2 GWPH 500 A<br>S/5½ BWPH 5 hr. D & A |        |

**ABANDONED**

County **Barton** State **Kansas**Sec. **14** (Blk. **20** (Sur. **12W** Map No.Operator **Texas Company**Well No. **1** Farm **Buckbee "C"**Elev. Location **SW NW SW**

|  |  |  |  |  |  |  |  |
|--|--|--|--|--|--|--|--|
|  |  |  |  |  |  |  |  |
|  |  |  |  |  |  |  |  |
990 Ft. From **N** Line **SW**330 Ft. From **W** Line Quarter1st. Report **MAR 3 1954**

Completion

Remarks

**Anschutz Drlg. - Contr.**Spudding Date **2-28-54**Drlg. Data **SW Buckbee Pool****10" @ 611 drlg. 1060**

County Barton State Kansas  
 Sec. 14 (Blk. 20 (Sur. 12W Map No.  
 Operator Texas Company  
 Well No. 1 Farm Buckbee "C"  
 Elev. 1814 Location SW NW SW



990 Ft. From N Line SW  
330 Ft. From W Line Quarter  
 1st. Report  
 Completion MAR 24 1954  
 Remarks SW Buckbee Pool  
Anschutz - Contr.  
 Spudding Date 2-28-54

Drig. Data D & A TD 3485  
10" @ 611 Heeb. 3003 Br. lime 3125  
Lans. 3143 Arb. 3378 TD 3382 7" @ 3381  
CO to 3382 DD 3427 1 qt oph 500 A  
16 go 185 gw 11 hr. DD 3451 DD 3482  
B/ wtr. DD 3485 10 go 4 bwph 3 hr.  
PB 3346 16/ 3292-98 1000 A wtr.  
54/ 3236-42 1000 A 8 bwph 4 hr.  
PB 3225 12/ 3212-16 2 gwph 500 A  
S/ 5½ bwph 5 hr.

D & A