


Map No. Kansas Greenwood Sec. 6 Twp. 25 R. 9
Well No. 1 Olson Farm
Lassen et al Company

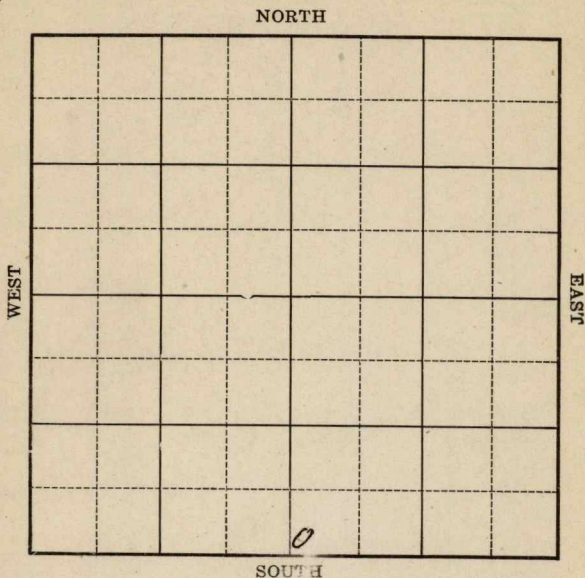

Location _____
Drilling Remarks _____

Rig Up _____
Drilling Remarks _____

RECORD

Cased _____ in. _____ ft.
Sand _____
Gas _____
Oil _____
Total Depth _____

PRODUCTION

1st 24 hrs. Nat. _____
1st 24 hrs. after shot _____
Gas _____ cu. ft.
Dry Hole _____
Abandoned _____

Map No. Kansas Sec. 6 Twp. 25 R. 9Well No. 1 Oleson FarmLassen et al Company

NORTH

WEST

EAST

SOUTH

Ft. from N. Line

330 Ft. from S. Line

Ft. from E. Line

330 Ft. from W. Line

Date

REPORT

1/263/11Bldg Rig3/183/25Rig4/14/74/14Drig 400'4/214/30Drig 12005/8" 15205/12" 2134.5/19Sand. 2134-2159 J.D.40750 BBls.

Form 26—1M Bks.—3-23—11959. *Greenwood*
K15 KANSAS Sec. *6* Twp. *25* R. *9*
Map No. _____

Well No. *1* *Oleson*
Oleson et al Company
_____ Contractor

SECTION PLAT

_____ Ft. from N. Line

330 Ft. from S. Line

_____ Ft. from E. Line

330 Ft. from W. Line

FIRST REPORTS

		<i>0</i>	

Location _____

Rig up _____

Drilling and Remarks:

Building Rig.

RECORD

Cased _____ in., _____ ft.

Sand _____

Gas _____

Oil _____

Total Depth _____

PRODUCTION

1st 24 hrs. Nat. _____

1st 24 hrs. after shot _____

Gas _____ Cu. Ft.

Dry Hole _____

Abandoned _____

Date

MAR 1 1 1926

CHAS. L. SHERWOOD

192

Scout

K15 KANSAS Sec 6 Twp. 25 R. 9
 Map No. _____

Well No. 1 Okeon
 Lassen et al Company

Contractor

COMPLETED

SECTION PLAT

_____ Ft. from N. Line

330 _____ Ft. from S. Line

_____ Ft. from E. Line

330 _____ Ft. from W. Line

		0	

Location _____

Rig up _____

Drilling and Remarks:

46/50 Bl.

RECORD

Cased _____ in., _____ ft.

Sand 2134-2159'

Gas _____

Oil _____

Total Depth 2159'

PRODUCTION

1st 24 hrs. Nat. _____

1st 24 hrs. after shot _____

Gas _____ Cu. Ft.

Dry Hole _____

Abandoned _____

Date

MAY 19 1926

192

CHAS. L. SHERWOOD

Scout