

Greenwood


KANSAS

SECTION 6 TOWNSHIP 25 RANGE 9 E

WELL NO. #3 Olson

COMPANY F. W. Sauder

NORTH

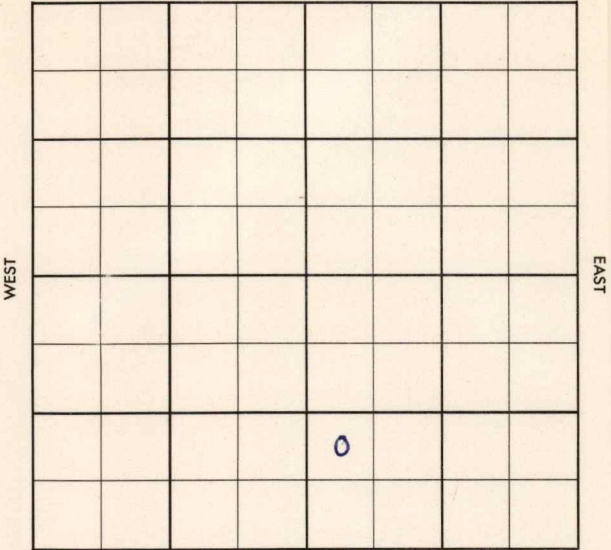

SOUTH

Greenwood

KANSAS

SEC. 6	TWP. 25	R. 9E
-----------	------------	----------

WELL NO.

#3 Olson

FARM

COMPANY

F.W. Sauder

CONTRACTOR

Co. tools

Wilkerson


Ft. from N. Line

Ft. from S. Line

Ft. from E. Line

Ft. from W. Line

NW SW SE (TWIN)

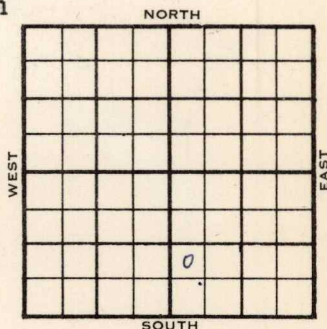

	ELEVATION	REPORT
1956		
1-18	Comm. 1-9-56 10" @ 737 Drlg. 1120	
2-8	5½" @ 2104 CO-2117 Frac BOP P/40 BOPD plus trace wtr. Cattle Sd 2103 TD 2117	

COMPLETED

County Greenwood

Elev. _____

Sec. 6Twp. 25Rge. 9ECompany F. W. SauderFarm Name OlsonNo. 3

TOPS

DEPTH

LOG

DATUM

Loc. in Sec. _____

Anh. _____

Tp. _____

H. _____

Tr. _____

Dg. _____

B.L. _____

L. _____

K.C. _____

B.K.C. _____

Ce. _____

C. _____

M. _____

M. _____

K. _____

Mz. _____

Mq. _____

V. _____

S. _____

S. _____

A. _____

R. _____

P.E. _____

G. _____

T.D. _____

NW SW SE

(twinwell)

Geol. _____

Contr. _____

Co. tools

Pool

Wilkerson

JAN 18 '56

FIRST REPORT

0

Date Comm. 1-9-56/ 10" @ 737 drlg. 1120

County Greenwood Elev. _____
 Sec. 6 Twp. 25 Rge. 9E
 Company F. W. Sauder
 Farm Name Olsen No. 3

TOPS	DEPTH	LOG	DATUM	Loc. in Sec. _____
Anh.				NW SW SE
Tp.				(twinwell)
H. <u>Carle sd</u>	<u>2103</u>			
Tr.				
Dg.				
Bl.				
L.				Geol. _____
K.C.				Cont. _____
B.K.C.				
Ce.				Co. tools
C.				
M.				Pool
M.				Wilkerson
K.				
Mz.				
Ms.				
V.				
S.				
S.				
A.				
R.				
Pe.				
G.				
IB.	<u>2117</u>			

Date Comm. 1-9-56 FEB 8 1956

10" @ 737 drlg. 1120 JAN 25 '56 / FEB 1 '56 X

FEB 8 '56 5 1/2 @ 2104 to 2117 Frac

P&P P. 40 Bopd + trace wtr