
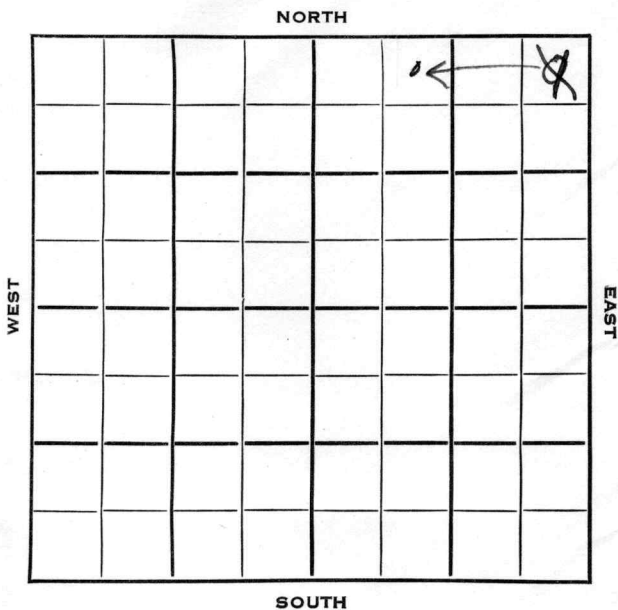


Section 16 Township 24 Range 13E
Well No. #1 Young
Company Berantz Drlg.

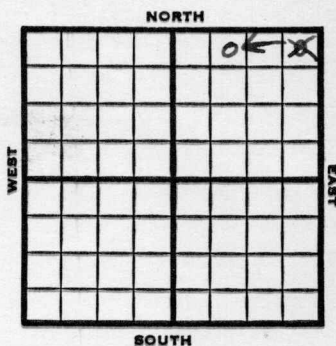

Greenwood KANSAS

Sec. 16 Twp. 24 R. 13EWell No. #1 Young FarmBerentz Drlg. CompanyBerentz Contractor330 Ft. from N. Line Ft. from S. Line330 Ft. from E. Line990 Ft. from W. Line~~NE NW NE~~~~NE NE NE~~

1953

Elev. -

REPORT

8/12

Drlg. 865'

8/19

Spud 8-5-53
TD 1618'
D&A**ABANDONED**

Kansas

Map No. _____ Sec. 16 Twp. 24 R. 13WWell No. 1 Young

Berentz Drlg.

Company

CORRECTION

Contractor

NE NW NE

SECTION PLAT

330 Ft. from N. Line

_____ Ft. from S. Line

_____ Ft. from E. Line

990 Ft. from W. Line

Greenwood County

Location _____

Rig up _____

Drilling and Remarks:

Reported

NE NE NE

RECORD

Cased _____ in., _____ ft.

Sand _____

Gas _____

Oil _____

Total Depth _____

PRODUCTION

1st 24 hrs. Nat. _____

1st 24 hrs. after shot _____

Gas _____ Cu. Ft.

Dry Hole _____

Abandoned _____

Date

AUG 10 1958

19

J. G. McGEHEE

Scout

County Greenwood State KansasSec. 16 (Blk.
Twp.) 24 (Sur.
Rge.) 13E Map No.Operator Berentz Drlg.Well No. 1 Farm YoungElev. Location NE NW NE330 Ft. From N Line NE990 Ft. From W Line Quarter1st. ReportCompletion AUG 19 1953RemarksBerentz - Contr.Spudding Date 8-5-53Drlg. DataTD 1618 D & A

J. G. McGEHEE