


Greenwood

Form 51-5M-11-31-Palace

Map No. **KANSAS** Sec. *6* Twp. *25* R. *9 E*

Well No. *9 Wilkerson* Farm
Franco - Central Company

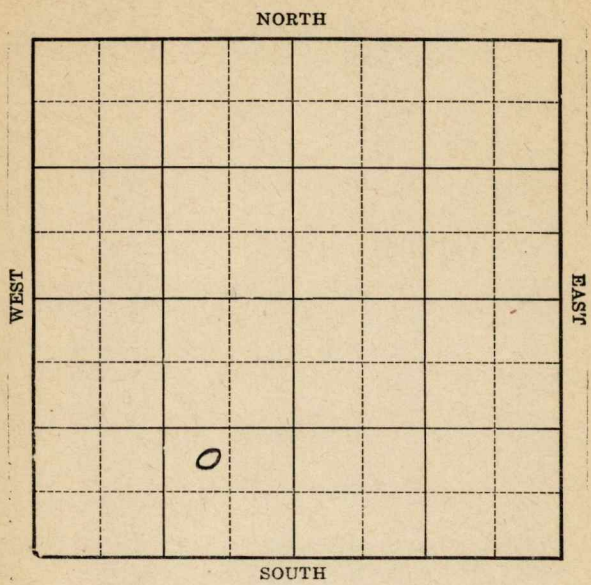

Location _____
Drilling Remarks _____

Rig Up _____
Drilling Remarks _____

RECORD

Cased _____ in. _____ ft.
Sand _____
Gas _____
Oil _____
Total Depth _____

PRODUCTION

1st 24 hrs. Nat. _____
1st 24 hrs. after shot _____
Gas _____ cu. ft.
Dry Hole _____
Abandoned _____

Greenwood

Map No. **KANSAS** Sec. 6 Twp 25 R. 9E


Well No. 9 Wilkerson Farm
Franeo-Central Company

 Ft. from N. Line

1000 Ft. from S. Line

800 Ft. from E. Line

 Ft. from W. Line

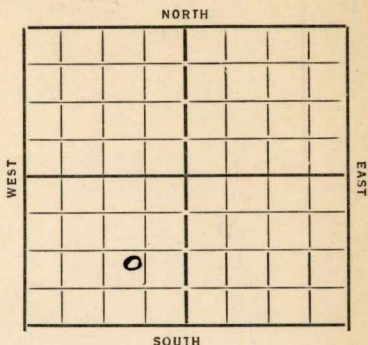

Date 1972

REPORT

5/2 Rig up Machine

5/10 Spud

5/18 12 1/2 197

5/25 —

5/31 dly 1300

6/7 " 1680

6/13 Sand 2108-28 TD 2229

D & A

ABANDONED

KANSASMap No. 15 Sec. 6 Twp. 25 R. 9EWell No. 9-WilkersonPrance-Central Company

Contractor

FIRST REPORTS**SECTION PLAT**

_____ Ft. from N. Line

1000 Ft. from S. Line800 Ft. from E. Line

_____ Ft. from W. Line

	o		

Location _____

RECORDRig up Machine

Cased _____ in., _____ ft.

Drilling and Remarks: _____

Sand _____

Gas _____

Oil _____

Total Depth _____

PRODUCTION

1st 24 hrs. Nat. _____

1st 24 hrs. after shot _____

Gas _____ Cu. Ft.

Dry Hole _____

Abandoned _____

Date

5-2-34

19

ORVAL MANNSCHRECK

Scout

Map No. 15 Sec. 6 Twp. 25 R. 9E

Well No. 9 - Wilkerson
Pharmer Central Company

Contractor _____

ABANDONED

SECTION PLAT

	0		

_____ Ft. from N. Line

1000 Ft. from S. Line

800 Ft. from E. Line

_____ Ft. from W. Line

Location _____

Rig up _____

Drilling and Remarks:

LOT # 7

RECORD

Cased _____ in. _____ ft.

Sand 2108-28

Gas _____

Oil _____

Total Depth 2229

PRODUCTION

1st 24 hrs. Nat. _____

1st 24 hrs. after shot _____

Gas _____ Cu. Ft.

Dry Hole _____

Abandoned _____

Date

ORVAL MANNSCHRECK

6-13-34 19

Scout