

NORTH

[illegible]

SOUTH

Rig Up.....

Drilling Remarks

RECORD

Sand.....

Gas.....

Oil.....

Total Depth.....

PRODUCTION

1st 24 hrs. Nat.....

1st 24 hrs. after shot.....

Gas.....cu. ft.....

Dry Hole.....

Abandoned.....

Map No. KANSAS Sec. 17 Twp. 24 R. 13^E


Well No. 1-Allis Farm
Schull Drly Co Company

 Ft. from N. Line

1120 Ft. from S. Line

250 Ft. from E. Line

 Ft. from W. Line

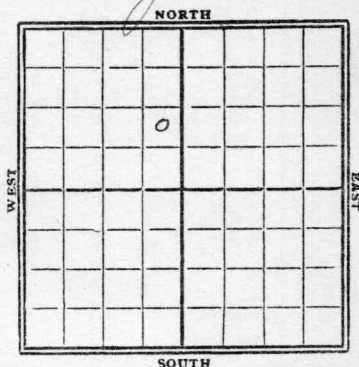

1929

Date

REPORT

5/22	Location
5/29	
6/5	
6/12	
6/19	Running up
6/26	Drly 400'
7/2	" 965'
7/10	Top line 1583' 1577 sand 1595-1603 100' oil - run 6"
7/17	Top line 1577 (correction) 1st break 1592-1601 TD 1601 swabbed 36 bbls 13 hrs running tubing Est 25 bbls
7/24	sand 1592-1601 TD 1601 Top line 1577 40 bbl oil Comp.

Sherwood

KANSAS

Map No. _____ Sec. *17* Twp. *24* R. *13*^E

Well No. *1* *allis*

Schell Dry Co Company

Contractor

FIRST REPORTS**SECTION PLAT**

_____ Ft. from N. Line

1120 Ft. from S. Line

750 Ft. from E. Line

_____ Ft. from W. Line

	o		

Location ☒

Rig up _____

Drilling and Remarks:

RECORD

Cased _____ in., _____ ft.

Sand _____

Gas _____

Oil _____

Total Depth _____

PRODUCTION

1st 24 hrs. Nat. _____

1st 24 hrs. after shot _____

Gas _____ Cu. Ft.

Dry Hole _____

Abandoned _____

Date

MAY 22 1929

192

CHAS. L. SHERWOOD

Scout

17 **KANSAS** Sec. 17 Twp. 24 R. 13

Well No. 1 Allis

Schull Drly Co

Company

Contractor

COMPLETE

_____ Ft. from N. Line

1120 Ft. from S. Line

750 Ft. from E. Line

_____ Ft. from W. Line

SECTION PLAT

	0		

Location _____

Rig up _____

Drilling and Remarks:

Top Line 1577'

40 Bls.

RECORD

Cased _____ in., _____ ft.

Sand 1592-1601

Gas _____

Oil _____

Total Depth 1601

PRODUCTION

1st 24 hrs. Nat. _____

1st 24 hrs. after shot _____

Gas _____ Cu. Ft.

Dry Hole _____

Abandoned _____

Date

JUL 24 1929

CHAS. L. SHERWOOD

19

Scout