


Map No. KANSAS Sec. 7 Twp. 25 R. 9E
 Well No. 3- Wilkinson Farm
Marylyn Oil Company

NORTH

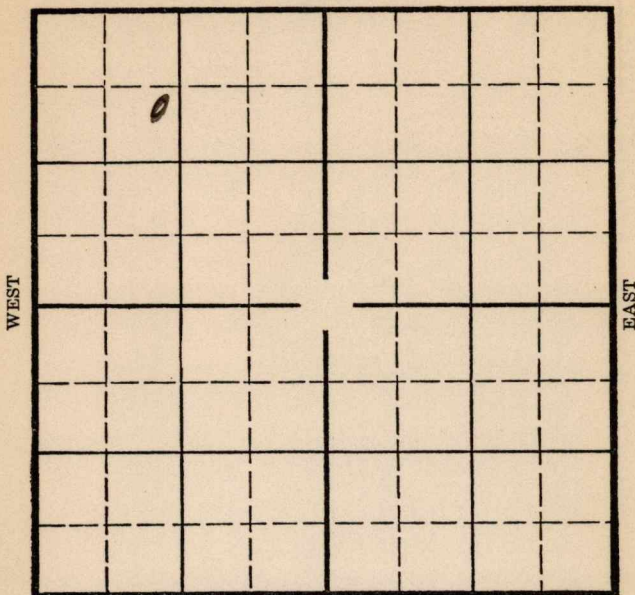

SOUTH

Location _____
 Drilling Remarks _____

Rig Up _____
 Drilling Remarks _____

RECORD

Cased _____ in. _____ ft.
 Sand _____
 Gas _____
 Oil _____
 Total Depth _____

PRODUCTION

1st 24 hrs. Nat. _____
 1st 24 hrs. after shot _____
 Gas _____ cu. ft. _____
 Dry Hole _____
 Abandoned _____

Greenwood

Map No. **KANSAS** Sec. *7* Twp. *25* R. *9E*


Well No. *3- Wilkerson* Farm
Marylyn Oil Company

800 Ft. from N. Line

_____ Ft. from S. Line

_____ Ft. from E. Line

1190 Ft. from W. Line

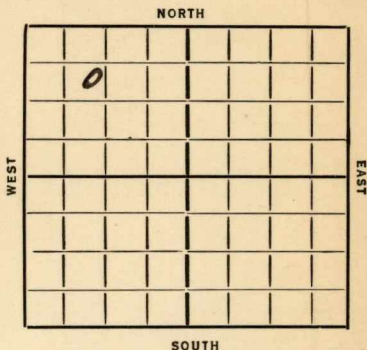

Date	REPORT
<i>1/36</i>	
<i>1/29</i>	<i>Spud</i>
<i>2/7</i>	<i>10" 890 woc</i>
<i>2/14</i>	<i>Alg 1085</i>
<i>2/21</i>	<i>" 1490</i>
<i>2/28</i>	<i>" 2070</i>
<i>3/6</i>	<i>Bart 2190</i> [CORRECTED TO T. BART. 2188]
<i>3/13</i>	<i>6"-2160 T. Bart. 2186 Show oil</i>
	<i>2187 T.D. 2199 shot w/60qts.</i>
	<i>swabbing.</i>
<i>3/25</i>	<i>Bartsville 2186</i>
	<i>T.D. 2199</i>
	<i>Shot 60 qts</i>
	<i>P.A.</i>

ABANDONED

Map No. 15 Sec. 7 Twp. 25 R. 9EWell No. 3-WilkersonMarylyn oil Company

Contractor

FIRST REPORTS

800 Ft. from N. Line

Ft. from S. Line

Ft. from E. Line

1190 Ft. from W. Line

SECTION PLAT

o			

Location

Rig up

Drilling and Remarks:

Spud

RECORD

Cased in., ft.

Sand

Gas

Oil

Total Depth

PRODUCTION

1st 24 hrs. Nat.

1st 24 hrs. after shot

Gas Cu. Ft.

Dry Hole

Abandoned

Date

ORVAL MANNSCHRECK

1-29-36 192 Scout

Map No. *15* Sec. *7* Twp. *25* R. *9E*

Well No. *3-Hulkerson*

Marylyn Oil Company

[Signature] Contractor

SECTION PLAT

500 Ft. from N. Line

..... Ft. from S. Line

..... Ft. from E. Line

1190 Ft. from W. Line

<i>0</i>			

ABANDONED

Location.....

Rig up.....

Drilling and Remarks:

Bartlesville 2186

Shot 60 gts.

L & A

RECORD

Cased.....in.,ft.

Sand.....

Gas.....

Oil.....

Total Depth *2199*

PRODUCTION

1st 24 hrs. Nat.....

1st 24 hrs. after shot.....

Gas.....Cu. Ft.

Dry Hole.....

Abandoned.....

Date

3/25/36 192.....

S. J. LEWIS

Scout