

Section 17 Township 24 Range 13 EWell No. # 3 AllisCompany Raymond Smith

			0				

NORTH

WEST

EAST

SOUTH

Greenwood KANSAS

SEC.	TWP.	R.
17	24	13E ✓

WELL NO.

3 Allis

FARM

COMPANY

Raymond Smith

CONTRACTOR

McLaughlin

Hinchman Pool

Ft. from N. Line


990

Ft. from S. Line

330

Ft. from E. Line

Ft. from W. Line

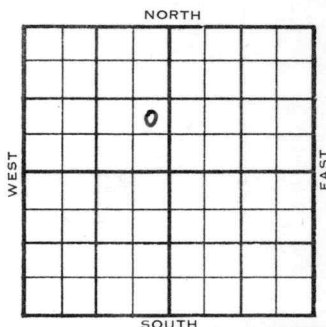

NE SE NW

1954	ELEVATION	REPORT
	-	

3/31

Spud 3-24-54

12" @ 42'

10" @ 275'

Dr1g. 745'

4/14

Spud 3-24-54

Oil Well

TD 1597'

12" @ 42'

10" @ 275'

Miss 1586'

TD 1597'

7" @ 1587'


CO to 1597'

P/10 bopd 2000A

Comp. 25 bopd

COMPLETED

County Greenwood State Kansas
 Sec. 17 (Blk. 24 (Sur. 13E Map No.
 (Twp. (Rge.
 Operator Raymond Smith
 Well No. 3 Farm Allis
 Elev. Location NE SE NW

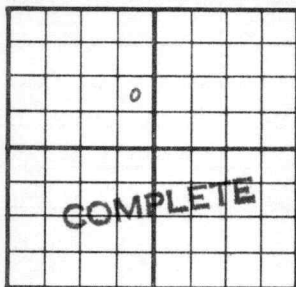

990 Ft. From S Line NW

330 Ft. From E Line Quarter

1st. Report

Completion APR 14 1954

Remarks Hinchman Pool

McLaughlin - Contr.

Spudding Date 3-24-54

Drilg. Data Oil well TD 1597
12" @ 42 10" @ 275 Miss. 1586
TD 1597 7" @ 1587 CO to 1597
P/ 10 bopd 2000 A Comp. 25 bopd

J. G. McGEHEE