


Map No. KANSAS Sec. 6 Twp. 25 R. 9^E
Well No. 8-Olson Farm
J.B. Murphy Company

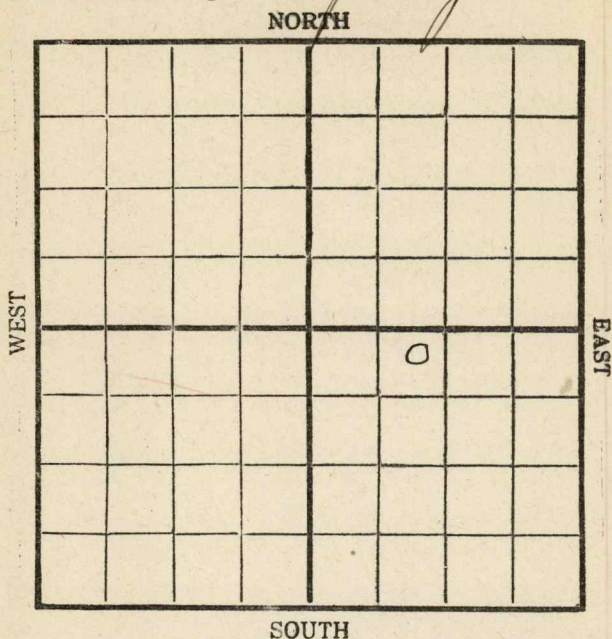

Location _____
Drilling Remarks _____

Rig Up _____
Drilling Remarks _____

RECORD

Cased _____ in. _____ ft.
Sand _____
Gas _____
Oil _____
Total Depth _____

PRODUCTION

1st 24 hrs. Nat. _____
1st 24 hrs. after shot _____
Gas _____ cu. ft. _____
Dry Hole _____
Abandoned _____


Map No. **KANSAS** Sec. 6 Twp. 25 R. 9^E
Well No. 8-Olson Farm
J. B. Murphy Company

200 Ft. from N. Line

_____ Ft. from S. Line

_____ Ft. from E. Line

1200 Ft. from W. Line

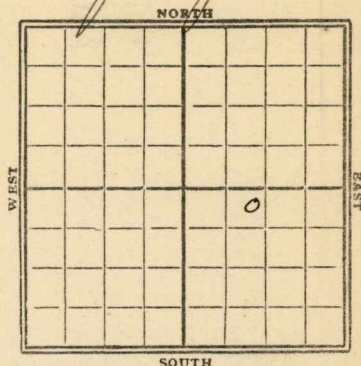

1929

Date

REPORT

Date	REPORT
8/7	Location
8/14	Drly 320'
8/21	" 2435
8/28	" 1320
9/4	" 2190'
9/11	sdly shale 2175-2200 T.D. 2200'
	dry & Abandoned

Greenwood

 Map No. **KANSAS** Sec. **6** Twp. **75** R. **9^E**

 Well No. **15** **J. B. Murphy** **Olson**
 _____ Company
 _____ Contractor
FIRST REPORTS**SECTION PLAT****200** Ft. from N. Line

_____ Ft. from S. Line

_____ Ft. from E. Line

1200 Ft. from W. Line

		0	

Location ☒

Rig up _____

Drilling and Remarks:

RECORD

Cased _____ in., _____ ft.

Sand _____

Gas _____

Oil _____

Total Depth _____

PRODUCTION

1st 24 hrs. Nat. _____

1st 24 hrs. after shot _____

Gas _____ Cu. Ft.

Dry Hole _____

Abandoned _____

Date

AUG 7 1929

192

CHAS. L. SHERWOOD

Scout

KANSAS

Gmwood

Map No. _____ Sec. 6 Twp. 25 R. 9Well No. 8 OlsonJ. B. Murphy Company

Contractor

COMPLETE

SECTION PLAT

200 Ft. from N. Line

_____ Ft. from S. Line

_____ Ft. from E. Line

1200 Ft. from W. Line

		0	

ABANDONED

Location _____

Rig up _____

Drilling and Remarks:

RECORD

Cased _____ in., _____ ft.

Sand Shale 2175-2200

Gas _____

Oil _____

Total Depth 2200**PRODUCTION**

1st 24 hrs. Nat. _____

1st 24 hrs. after shot _____

Gas _____ Cu. Ft.

Dry Hole ☒Abandoned ☒

Date

SEP 11 1929**CHAS. L. SHERWOOD**

192 _____ Scout