

Form 51—5M—11-31—Palace

Form 51-5M-11-51-Palace
Map No. KANSAS Sec. 17 Twp. 24 R. 13E

Well No. 2 Albans Farm
Anderson & Pence Company

NORTH

WEST

EAST

SOUTH

Location

Drilling Remarks

Rig Up

Drilling Remarks

RECORD

Cased _____ in. _____ ft.

Sand

Gas

Oil

Total Depth-----

PRODUCTION

1st 24 hrs. Nat. _____

1st 24 hrs. after shot-----

Gas ----- cu. ft. -----

Dry Hole

Abandoned.....

Greenwood

Map No. KANSAS Sec. 17 Twp. 24 R. 13E

Well No. 2 Albmaus Farm


Anderson & Pence Company

1090 Ft. from N. Line

_____ Ft. from S. Line

_____ Ft. from E. Line

1090 Ft. from W. Line

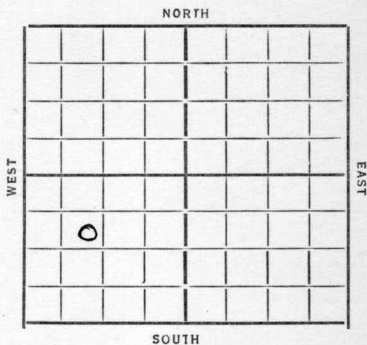

Date
1934

REPORT

3/7 Spudding

3/15 Drill 703

3/22 " 1100

4/4 Miss L. 1580 7D 1607

25 BBL oil

COMPLETED

Map No. 17 Sec. 17 Twp. 24 R. 13EWell No. 2. AlbmanoAnderson + Pence Company

Contractor


SECTION PLAT

FIRST REPORTS

1070 Ft. from N. Line

Ft. from S. Line

Ft. from E. Line

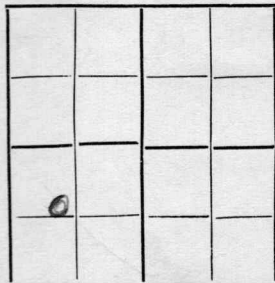1070 Ft. from W. Line

Location

Rig up

Drilling and Remarks:

Spudding

RECORD

Cased _____ in., _____ ft.

Sand _____

Gas _____

Oil _____

Total Depth _____

PRODUCTION

1st 24 hrs. Nat. _____

1st 24 hrs. after shot _____

Gas _____ Cu. Ft.

Dry Hole _____

Abandoned _____

Date

3-7-34 192 P. Mannickbreck Scout

Map No. 17 Sec. 17 Twp. 24 R. 13 EWell No. 2-AlbmanAndersson & Pence Company

Contractor

COMPLETED

SECTION PLAT

1070 Ft. from N. Line

Ft. from S. Line

Ft. from E. Line

1070 Ft. from W. Line

Location

Rig up

Drilling and Remarks:

RECORD

Cased in, ft.

Sand Miss. L. 1580

Gas

Oil

Total Depth 1607

PRODUCTION

1st 24 hrs. Nat.

1st 24 hrs. after shot

Gas Cu. Ft.

Dry Hole

Abandoned

25 fbls
oil

Date

4-4-34 192O. Manschreck Scout