


N

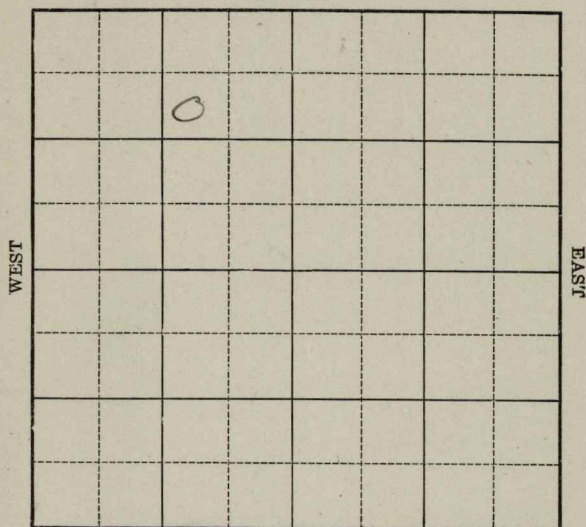

Map No. _____ Sec. 7 Twp. 25 R. 9
 Well No. 2-Wilkinson Farm
Lassen et al Company

NORTH

990 Ft. from N. Line

_____ Ft. from S. Line

990 Ft. from E. Line

_____ Ft. from W. Line

WEST

EAST

SOUTH

1927

Date

REPORT

9/7	Bldg Rig
9/14	Rig
9/29	Spudding
10/6	Spudded + S.D.
10/12	Drlg 450-
10/19	S.D. 450
10/27	Drlg 1200
11/2	setg. 8" 1392'
11/9	Drlg 1410-
11/16	Sand 2258-88 - shot 110 qts.
	Cleaning out. Est. 25 bbls -
11/23	2258-2288
	T.D. 2288
	110/52 bbls

15- **KANSAS** *Sherwood*
 Map No. _____ Sec. *7* Twp. *25* R. *9*
 Well No. *2* *Wilkinson*
Lassen et al _____ Company

Contractor _____

FIRST REPORTS*990* _____ Ft. from N. Line

_____ Ft. from S. Line

990 _____ Ft. from E. Line

_____ Ft. from W. Line

SECTION PLAT

	o		

Location _____

Rig up _____

Drilling and Remarks:

This property
was formerly
owned by Shugart
et al

RECORD

Cased _____ in., _____ ft.

Sand _____

Gas _____

Oil _____

Total Depth _____

PRODUCTION

1st 24 hrs. Nat. _____

1st 24 hrs. after shot _____

Gas _____ Cu. Ft.

Dry Hole _____

Abandoned _____

Date

SEP 7 - 1927

CHAS. L. SHERWOOD

192

Scout

15 **KANSAS** *Greenwood*
 Map No. _____ Sec. *7* Twp. *25* R. *9*
 Well No. *Wilkinson*
Hessen @ 4L _____ Company

Contractor _____

COMPLETED**SECTION PLAT***990* Ft. from N. Line

_____ Ft. from S. Line

990 Ft. from E. Line

_____ Ft. from W. Line

	0		

Location _____

Rig up _____

Drilling and Remarks:

1107 50 Bbs

RECORD

Cased _____ in., _____ ft.

Sand *2258-2288*

Gas _____

Oil _____

Total Depth *2288***PRODUCTION**

1st 24 hrs. Nat. _____

1st 24 hrs. after shot _____

Gas _____ Cu. Ft.

Dry Hole _____

Abandoned _____

Date

NOV 23 1927 **CHAS. L. SHERWOOD**
 _____ 192 _____ Scout