


Map No. **KANSAS** Sec. **7** Twp. **25** R. **9E**
Well No. **#4 Wilkerson** (*Wilkinson*) Farm
Marylyn Oil Company

NORTH

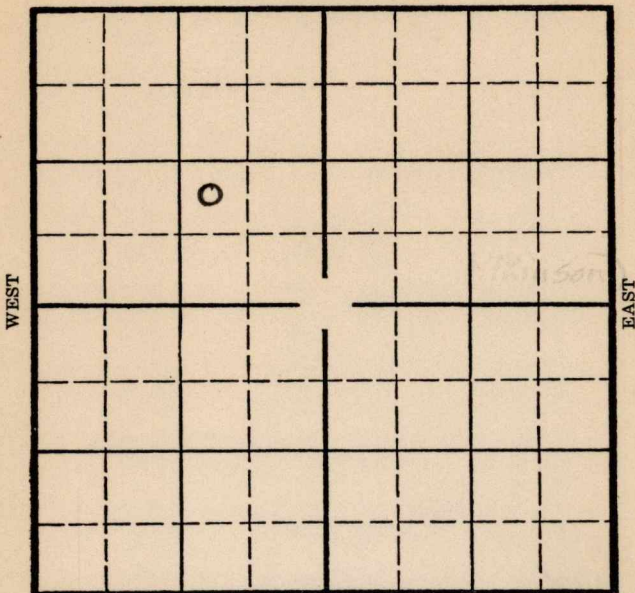

SOUTH

Location _____
Drilling Remarks _____

Rig Up _____
Drilling Remarks _____

RECORD

PRODUCTION

Cased _____ in. _____ ft.
Sand _____
Gas _____
Oil _____
Total Depth _____

1st 24 hrs. Nat. _____
1st 24 hrs. after shot _____
Gas _____ cu. ft. _____
Dry Hole _____
Abandoned _____

Map No. 15 Sec. 7 Twp. 25 R. 9E

Well No. 4 - Wilkerson

Marylyn Oil Company

Contractor

FIRST REPORTS

SECTION PLAT

Ft. from N. Line

990 Ft. from S. Line

990 Ft. from E. Line

Ft. from W. Line

| | | | |
|--|---|--|--|
| | | | |
| | 0 | | |
| | | | |
| | | | |
| | | | |

Location

Rig up

Drilling and Remarks:

Spud

RECORD

Cased in., ft.

Sand

Gas

Oil

Total Depth

PRODUCTION

1st 24 hrs. Nat.

1st 24 hrs. after shot

Gas Cu. Ft.

Dry Hole

Abandoned

Date

4-1-36 192

ORVAL MANNSCHRECK

Scout

Map No. 15 Sec. 7 Twp. 25 R. 9E

Well No. 4 Wilkerson

Wagon Oil Company

Contractor

SECTION PLAT

| | | | |
|--|---|--|--|
| | | | |
| | 0 | | |
| | | | |
| | | | |

_____ Ft. from N. Line

990 Ft. from S. Line

990 Ft. from E. Line

_____ Ft. from W. Line

ABANDONED

Location _____

Rig up _____

Drilling and Remarks:

Sands 2246.

W & A

RECORD

Cased _____ in., _____ ft.

Sand _____

Gas _____

Oil _____

Total Depth 2269

PRODUCTION

1st 24 hrs. Nat. _____

1st 24 hrs. after shot _____

Gas _____ Cu. Ft.

Dry Hole _____

Abandoned _____

Date

MAY 20 1936 19

S. J. LEWIS Scout