



*Greenwood*

Map No. *Kansas* Sec. *18* Twp. *25* R. *10*

Well No. *1 Hatch* Farm


*Fisher & Laucke* Company

\_\_\_\_\_ Ft. from N. Line

*990* Ft. from S. Line

\_\_\_\_\_ Ft. from E. Line

*330* Ft. from W. Line

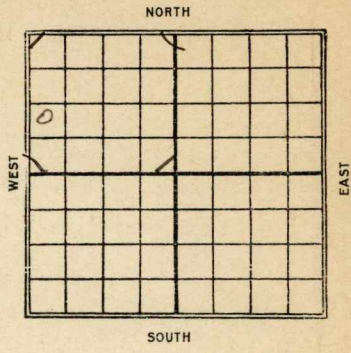

Date	REPORT
<i>1927</i>	
<i>1/19</i>	<i>Location</i>
<i>1/26</i>	<i>same</i>
<i>2/3</i>	<i>—</i>
<i>2/10</i>	<i>—</i>
<i>2/17</i>	<i>—</i>
<i>2/24</i>	<i>—</i>
<i>3/2</i>	<i>—</i>
<i>3/9</i>	<i>—</i>
<i>3/16</i>	<i>—</i>
<i>3/24</i>	<i>abnd location</i>

16 KANSAS

Sherwood

Map No. \_\_\_\_\_ Sec. 18 Twp. 25 R. 10

Well No. 1 Hatchy \_\_\_\_\_

Lisher & Laucke

Company

Contractor

FIRST REPORTS

SECTION PLAT

\_\_\_\_\_ Ft. from N. Line

990 Ft. from S. Line

\_\_\_\_\_ Ft. from E. Line

330 Ft. from W. Line

o			

Location ✓ \_\_\_\_\_

Rig up \_\_\_\_\_

Drilling and Remarks:

RECORD

Cased \_\_\_\_\_ in., \_\_\_\_\_ ft.

Sand \_\_\_\_\_

Gas \_\_\_\_\_

Oil \_\_\_\_\_

Total Depth \_\_\_\_\_

PRODUCTION

1st 24 hrs. Nat. \_\_\_\_\_

1st 24 hrs. after shot \_\_\_\_\_

Gas \_\_\_\_\_ Cu. Ft.

Dry Hole \_\_\_\_\_

Abandoned \_\_\_\_\_

Date

JAN 19 1927

CHAS. L. SHERWOOD

*Sherwood*

16 **KANSAS** Map No. Sec. 18 Twp. 25 R. 10

Well No. 1 Hatch

*Fisher & Laucke* Company

Contractor

**COMPLETED**

**SECTION PLAT**

o			

----- Ft. from N. Line

990 Ft. from S. Line

----- Ft. from E. Line

320 Ft. from W. Line

**ABANDONED**

Location -----

Rig up -----

Drilling and Remarks:

**RECORD**

Cased ----- in., ----- ft.

Sand -----

Gas -----

Oil -----

Total Depth -----

**PRODUCTION**

1st 24 hrs. Nat. -----

1st 24 hrs. after shot -----

Gas ----- Cu. Ft.

Dry Hole -----

Abandoned *Location*

*Abd Location*

Date

**MAR 24 1927 CHAS. L. SHERWOOD**

----- 192 ----- Scout