


Map No. _____ Sec. 18 Twp. 25 R. 10
 Well No. 1 Kirkpatrick Farm _____
Everly & Lettall Company _____

NORTH

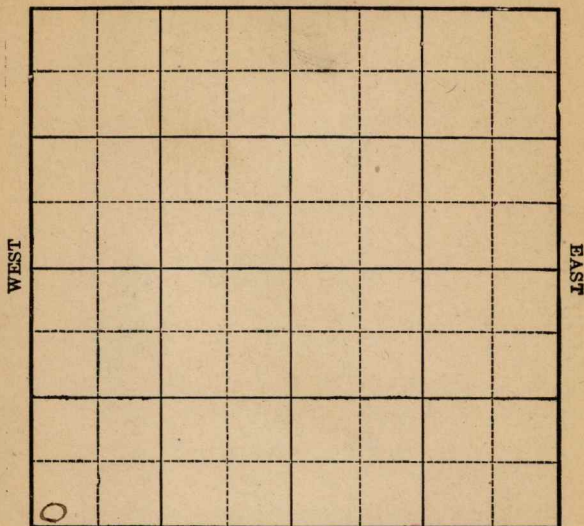

SOUTH

FIRST REPORT

Location _____

Rig up _____

Drilling Remarks:

Drilling Remarks:

RECORD

Cased _____ in. _____ ft.

Sand _____

Gas _____

Oil _____

Total Depth _____

PRODUCTION

1st 24 hrs Nat. _____

1st 24 hrs. after shot _____


Gas _____ cu. ft.

Dry Hole _____

Abandoned _____

Map No. _____ Sec. 18 Twp. 25 R. 10
Well No. 1 Kirkpatrick Farm
Everly & Littell Company

_____ Ft. from N. Line
200 Ft. from S. Line
_____ Ft. from E. Line
200 Ft. from W. Line

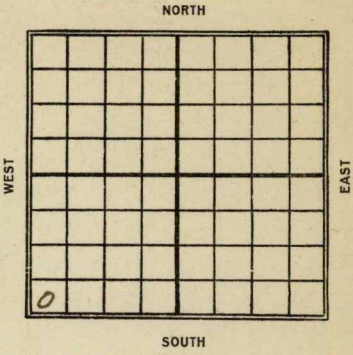

Date	REPORT
1923	
1/6	Timbers,
3/30	D. + A. 2145'

Map No. _____ Sec. 18 Twp. 25 R. 10
 Well No. 1 Kirkpatrick
Everly T. Littel Company
 Contractor

FIRST REPORT

_____ Ft. from N. Line
200 _____ Ft. from S. Line
 _____ Ft. from E. Line
200 _____ Ft. from W. Line

SECTION PLAT

Location _____

Rig up _____

Drilling and Remarks:

hinders

RECORD

Cased _____ in., _____ ft.

Sand _____

Gas _____

Oil _____

Total Depth _____

PRODUCTION

1st 24 hrs. Nat. _____

1st 24 hrs. after shot _____

Gas _____ Cu. Ft.

Dry Hole _____

Abandoned _____

Date

JAN 6 1923

M. A. BENEAR

191

Scout

Map No. **KANSAS** ¹⁶ Sec. 18 Twp. 25 R. 10
Well No. 1 Kirkpatrick
Emery & Litterell Company
Contractor

ABANDONED SECTION PLAT

----- Ft. from N. Line
200 Ft. from S. Line
----- Ft. from E. Line
200 Ft. from W. Line

0			

Location -----

Rig up -----

Drilling and Remarks:

Tap Line 2115
1040 2145

RECORD

Cased ----- in., ----- ft.
Sand -----
Gas -----
Oil -----
Total Depth -----

PRODUCTION

1st 24 hrs. Nat. -----
1st 24 hrs. after shot -----
Gas ----- Cu. Ft.
Dry Hole -----
Abandoned -----

Date

MAR 30 1923

M. A. BENEAR