

Greenwood


KANSAS

DX 78-1

Section 22 Township 25 Range 10E

Well No. #1 Marlin

Company Race Parks

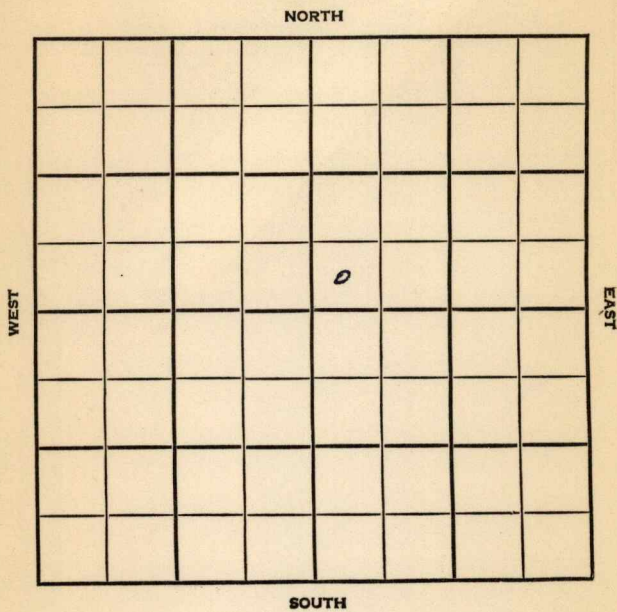

Greenwood

KANSAS

SEC.	TWP.	R.
22	25	10 E

WELL NO.

1 Marlin FARM

COMPANY

Race Parks

CONTRACTOR

Sunflower Drlg.
Wildcat


Ft. from N. Line

330 Ft. from S. Line

Ft. from E. Line

330 Ft. from W. Line

SW SW NE

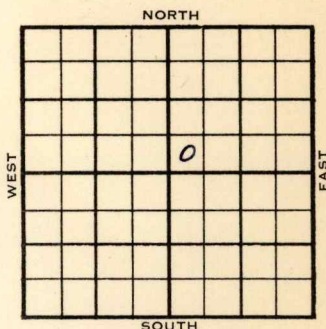

ELEVATION

REPORT

1954

9/8

Spud 8-19-54

D & A TD 2158 8" @ 40

Lans 1029 B. Lans. 1170' KC 1318

B KC 1498 Peru 1655 Cherokee 1782

Bart 1971 Burgess 2119 Miss 2122

TD 2158' D & A

FIRST REPORT

ABANDONED

County **Greenwood** State **Kansas**
 Sec. **22** (Blk.) **25** (Sur.) **10E** Map No.
 Operator **Race Parks**
 Well No. **1** Farm **Marlin**
 Elev. Location **SW SW NE**



330 Ft. From **S** Line **NE**
330 Ft. From **W** Line Quarter
 1st. Report **SEP 8 1954**
 Completion **SEP 8 1954**
 Remarks
Sunflower Drlg. - Contr.
 Spudding Date **8-19-54**

Drlg. Data **D & A** **TD 2158** **Wildcat**
8" @ 40 **Lans. 1029** **B. Lans. 1170**
KC 1318 **B KC 1498** **Peru 1655**
Cherokee 1782 **Bart. 1971** **Burgess 2119**
Miss. 2122 **TD 2158**

D & A

FABEN GILSTRAP