


Section 24 Township 20 Range 15W

Well No. #1 A. Unruh

Company Harbar Drlg. et al

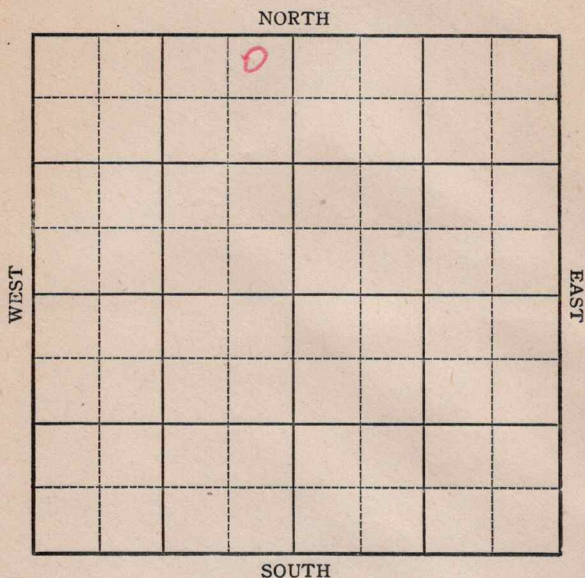

KANSAS

Barton

Sec. 24 Twp. 20 R. 15W

Well No. 1 A. Unruh Farm

Harbar Drlg. etal Company

Wildcat


330 Ft. from N. Line

 Ft. from S. Line

330 Ft. from E. Line

 Ft. from W. Line

NE NW Elev. 1919

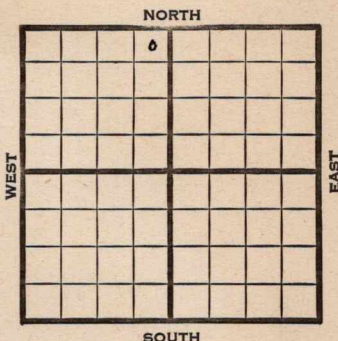

1945

REPORT

5/16 Location

5/24 Derrick

5/31 Drlg. 200'

6/8 8" @ 899 anhy 920 Drlg. 1867

6/14 Drlg. 2982

6/21 Lams 3327

Drlg. 3554

6/28 Anhy 876

Heebner 3201

Lams 3297 corrected

Simp 3557

Arb 3565

TD 3690

5" @ 3690 RUST

7/10 Flowing 5 hbbls. per hour (Tel)

7/11 Flow 30 oil in 12 hrs. 1/4 M Gas

7/19 " " " " " " "

7/26 " " " " " " "

8/1 500 acid.

Flow 10 oil per hr. 1/4" choke. 4 hrs.

8/8 " " " " " "

8/15 " " " " " "

8/22 Arb. 3565

5" @ 3690

Perf. Arb. 500 acid

TD 3690

Bomb Pot 2565 oil plus 10% wtr.

Grav. 39.0

COMPLETED


Kansas Pool Name WildcatMap No. 82 Sec. 24 Twp. 20 R. 15WWell No. 1 A. UnruhHarbar Drlg. etal Company

FIRST REPORT

Contractor

NE NW

SECTION PLAT

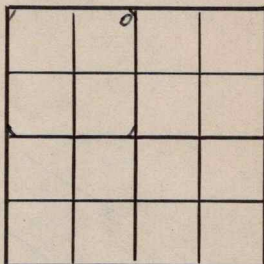330 Ft. from N. Line Ft. from S. Line330 Ft. from E. Line Ft. from W. LineBartonLocation XRig up

Drilling and Remarks:

RECORD

Cased in., ft.Sand Gas Oil Total Depth

PRODUCTION

1st 24 hrs. Nat. 1st 24 hrs. after shot Gas Cu. Ft.Dry Hole Abandoned

Date

MAY 16 1945 19S. J. LEWIS Scout

KANSASKansas Pool Name UnruhMap No. 82 Sec. 24 Twp. 20 R. 15WWell No. 1 A. Unruh

Harbar Drlg. etal

Company

COMPLETED

Contractor

NE NW

E1, 1919
SECTION PLAT

	6		

330 Ft. from N. Line Ft. from S. Line330 Ft. from E. Line Ft. from W. Line

Barton County

Location

Rig up

Drilling and Remarks:


Cased _____ in., _____ ft.

Sand _____

Gas _____

Oil _____

Total Depth 2690**PRODUCTION**

1st 24 hrs. Nat. _____

1st 24 hrs. after shot _____

Gas _____ Cu. Ft.

Dry Hole _____

Abandoned _____

Date

AUG 22 1945

19

S. J. LEWIS

Scout