

Company Magnolia Pet.

EAST

SOUTH

Barton

KANSAS

Sec. 24 Twp. 20 R. 15W

Well No. #2 M. Radenberg. Farm

MagnoliaPet. Company

Contractor

Unruh Pool


Ft. from N. Line

990 Ft. from S. Line

330 Ft. from E. Line

Ft. from W. Line

NE SE SE

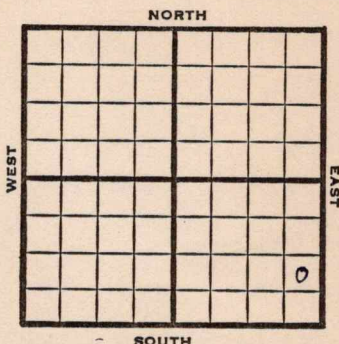

1953

Elev. 1913'

REPORT

4/29

Location

5/7

8" @ 898'
Drlg 1560'

5/21

Heeb 3209, Doug 3243, Lans 3306,
Simp 3563
DST 3559-81, 1 hr., 700' gassy oil
Arb. 3607
DST 3619-32, 1 hr., 2500' sulp wtr.
1135#
RTD 3663
5" @ 3662

5/27

Spud 4-30-53
Oil Well
TD 3663'
8" @ 898
Heeb 3209, Doug 3243, Lans 3306, Simp
3563
DST 3559-81, opn 1 hr., rec. 700'
gassy oil
Arb 3607
DST 3619-32, opn 1 hr., rec. 2500'
sul wtr., 1135#
TD 3663
5" @ 3662
PB 3626
24/3566-74, S/4 boph 9 hrs., Hydro
F/40 bo 1 hr., F/55 bo 2nd hr.

OVER

751305

#2 M. Radenberg
(Information Brought Forward)

1953

5/27

F/529 bo 24 hrs., F/160 bo 16 hrs.
Comp F/360 bopd

COMPLETED

County Barton State KansasSec. 24 (Blk. Twp.) 20 (Sur. Rge.) 15W Map No.Operator Magnolia Pet.Well No. 2 Farm M. RadenbergElev. Location NE SE SE

FIRST REPORT

0

990 Ft. From S Line SE330 Ft. From E Line Quarter1st. Report APR 29 1953

Completion

Remarks

Spudding Date

Drlg. Data Unruh Pool

Location

County Barton State Kansas
 Sec. 24 (Blk.) 20 (Sur.) 15W Map No.
 Operator Magnolia Pet.
 Well No. 2 Farm M. Radenberg
 Elev. 1913 Location NE SE SE



990 Ft. From S Line SE
 330 Ft. From E Line Quarter

1st. Report

Completion MAY 27 1953

Remarks Unruh Pool

Spudding Date 4-30-53

Drlg. Data Oil well TD 3663
8" @898 Heeb. 3209 Doug. 3243
Ians. 3306 Simp. 3563 DST 3559-81
open 1 hr. Rec. 700' gassy oil
Arb. 3607 DST 3619-32 open 1 hr.
Rec. 2500' sul. wtr. 1135# TD 3663
5" @ 3662 PB 3626 24/ 3566-74
S/ 4 boph 9 hr. Hydro. F/ 40 bo 1 hr.
F/ 55 bo 2nd hr. F/ 529 bo 24 hr.
F/ 160 bo 16 hr.
Comp. F/ 360 bopd

J. G. McGEHEE