


Map No. _____ Sec. 30 Twp. 25 R. 9
Well No. 15 Ladd _____ Farm _____
Mid-Kansas _____ Company _____

NORTH

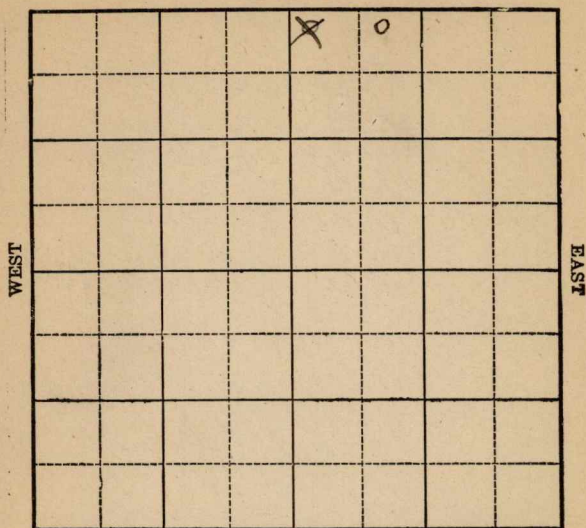

SOUTH

Location _____

Drilling Remarks:

Rig up _____

Drilling Remarks:

RECORD

Cased _____ in. _____ ft.

Sand _____

Gas _____

Oil _____

Total Depth_____

PRODUCTION

1st 24 hrs Nat. _____

1st 24 hrs. after shot_____

Gas _____ cu. ft.

Dry Hole_____

Abandoned _____

Map No. _____ Sec. 30 Twp. 23 R. 9

Well No. 13 Fadd Farm


Mid-Kansas Company

200 Ft. from N. Line

_____ Ft. from S. Line

_____ Ft. from E. Line

735
200 Ft. from W. Line

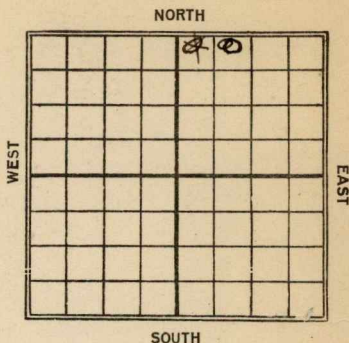

Date 1923

REPORT

4/20	R.O.S.
------	--------

'8/9	Land 2375-2473 - 200 bbls
------	---------------------------

KANSAS

Map No. _____ Sec. 30 Twp. 25 R. 9

Well No. 13 Sadd

Mid-Kansas Company

Contractor

FIRST REPORT

200 Ft. from N. Line

_____ Ft. from S. Line

_____ Ft. from E. Line

200 Ft. from W. Line

SECTION PLAT

		○	

Location _____

Rig up _____

Drilling and Remarks:

R.O.G.

RECORD

Cased _____ in., _____ ft.

Sand _____

Gas _____

Oil _____

Total Depth _____

PRODUCTION

1st 24 hrs. Nat. _____

1st 24 hrs. after shot _____

Gas _____ Cu. Ft.

Dry Hole _____

Abandoned _____

Date

APR 20 1923

_____ 191 _____ Scout

Map No. 15 Kans 30 Sec. 30 Twp. 25 R. 9Well No. 15 LaddMid-Kansas Company

Contractor

SECTION PLAT

		10	

200 Ft. from N. Line

Ft. from S. Line

Ft. from E. Line

735 Ft. from W. Line

Location

Rig up

Drilling and Remarks:

sand 2375-2473200 lbs
nat,

RECORD

Cased _____ in., _____ ft.

Sand _____

Gas _____

Oil _____

Total Depth _____

PRODUCTION

1st 24 hrs. Nat. _____

1st 24 hrs. after shot _____

Gas _____ Cu. Ft.

Dry Hole _____

Abandoned _____


Date

8/4 1923

Scout

RETURNED TO CORRECTION

Please check this
 no map shows
 #14 prod. well
 at this corrected
 location

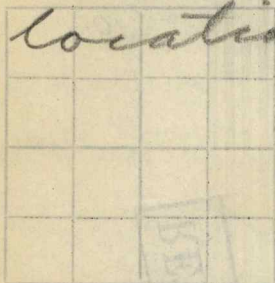

RECORD
 Location
 Rig up
 Drilling and Remarks:
 Cased in
 Sand
 Gas
 Oil
 Total Depth

PRODUCTION
 24 hrs. Nat.
 24 hrs. after shot
 Cu. Ft.
 Hole
 Returned
 Cards
 Tracing
 J. S. C. map
 Frantz map
 Moody map
 Frantz plat book
 Moody plat book

Map No. _____ Sec. 30 Twp. 25 R. 9Well No. -9-10-11-12-13-14+15Mid. Kansas 10+9 Companyon acct. "L" Ladd ContractorWells # 1-2-3-4-5-6-7
9-10-11-12-13-14-15

SECTION PLAT

		14 15	
		13	
		12	
		11	
		10	
		9	

_____ Ft. from N. Line

_____ Ft. from S. Line

_____ Ft. from E. Line

_____ Ft. from W. Line

Location _____

Rig up _____

Drilling and Remarks:

RECORD

Cased _____ in., _____ ft.

Sand _____

Gas _____

Oil _____

Total Depth _____

PRODUCTION

1st 24 hrs. Nat. _____

1st 24 hrs. after shot _____

Gas _____ Cu. Ft.

Dry Hole _____

Abandoned _____

Date _____