


KANSAS

Greenwood

Section 17 Township 24 Range 13-E


Well No. 2 Errickson

Company Anderson & Reed

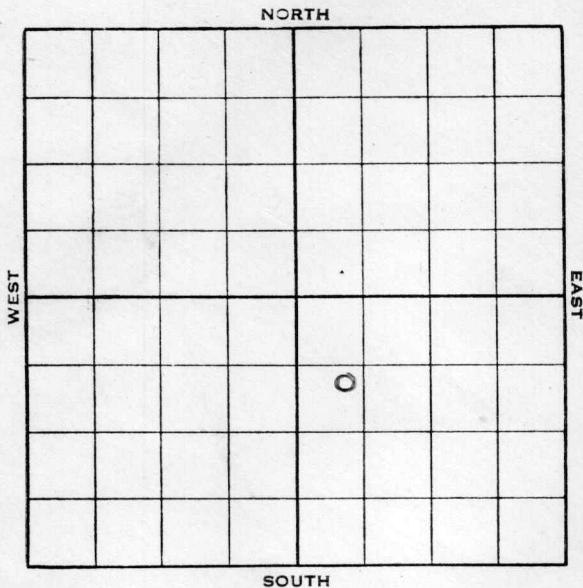

KANSAS

Greenwood

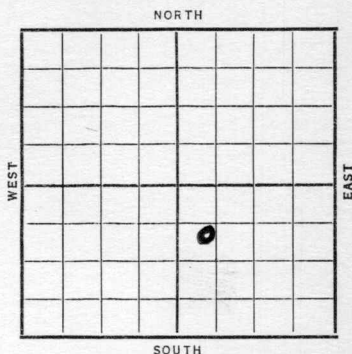Sec. 17 Twp. 24 R. 13-EWell No. #2 Errickson FarmAnderson & Reed Company750 Ft. from N. Line Ft. from S. Line Ft. from E. Line540 Ft. from W. Line

Date

REPORT

1938

2/9

Mach.

2/11

"

2/18

15" @ 37'. 12" @ 295'.

Drlg. 735'.

2/26

" " "

3/2

6" @ 1605'.

Chat 1605'.

T.D. 1621'.

1000 acid.

20 oil & 10 water.

COMPLETED

Greenwood KANSASMap No. 17 Sec. 17 Twp. 24 R. 13EWell No. 2 Errickson
Anderson & Reed Company

Contractor

FIRST REPORT

Approx.

SW NW SE

750 Ft. from N. Line

_____ Ft. from S. Line

_____ Ft. from E. Line

540 Ft. from W. Line**SECTION PLAT**

		o	

Location _____

Rig up _____

Drilling and Remarks:

Mach**RECORD**

Cased _____ in., _____ ft.

Sand _____

Gas _____

Oil _____

Total Depth _____

PRODUCTION

1st 24 hrs. Nat. _____

1st 24 hrs. after shot _____

Gas _____ Cu. Ft.

Dry Hole _____

Abandoned _____

Date

FEB 9 1938 19**H. D. Hatfield**

Scout

Greenwood KANSAS

Map No. 17 Sec. 17 Twp. 24 R. 13EWell No. 2 ErricksonAnderson & Reed

Company

Contractor

COMPLETED

SECTION PLAT

Approx. SW NW SE

750 Ft. from N. Line

_____ Ft. from S. Line

_____ Ft. from E. Line

540 Ft. from W. Line

		0	

Location _____

Rig up _____

Drilling and Remarks:

1000 Acid20 oil10 WTR

RECORD

Cased 6 in., 1605 ft.Sand CHAT 1605

Gas _____

Oil _____

Total Depth 1621

PRODUCTION

1st 24 hrs. Nat. _____

1st 24 hrs. after shot _____

Gas _____ Cu. Ft.

Dry Hole _____

Abandoned _____

Date

MAR 2 - 1938

19

H. D. Hatfield Scout