


Map No. Kansas Greenwood Sec. 19 Twp. 25 R. 10
 Well No. 1 Henry Farm
Elwell et al Company

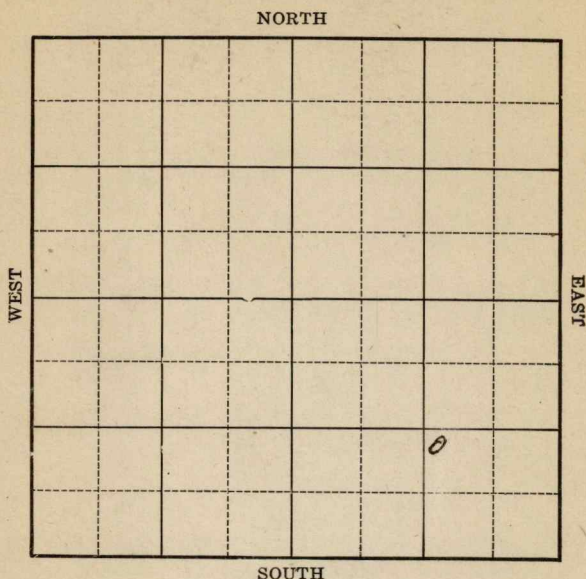

Location _____

Drilling Remarks _____

Rig Up _____

Drilling Remarks _____

RECORD

Cased _____ in. _____ ft.

Sand _____

Gas _____

Oil _____

Total Depth _____

PRODUCTION

1st 24 hrs. Nat. _____

1st 24 hrs. after shot _____

Gas _____ cu. ft.

Dry Hole _____

Abandoned _____


Greenwood

Map No. _____ Sec. 19 Twp. 25 R. 10Well No. 1 Humley Farm _____
C. Lowell et al Company

_____ Ft. from N. Line

1020 Ft. from S. Line1020 Ft. from E. Line

_____ Ft. from W. Line

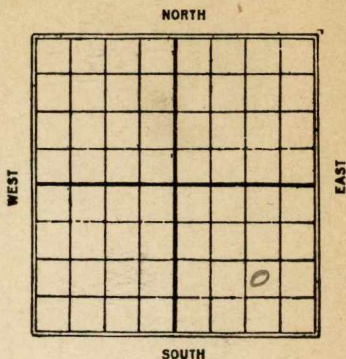

1926

Date

REPORT

3/3 Location3/103/183/254/14/74/144/214/305/85/125/196/26/9

Rig

Dlq 500'

S.D. 900'

Dlq. 1400'

Broken sd. 1940-50' Top
line 2077' lat break 2111-

S.D. 2152' H.F. V.

D. & A. 2152

K16 KANSAS Sec. 19 Twp. 25 R. 10

Well No. *Hen by*
Edwell of *44* Company

Contractor

SECTION PLAT

			o

_____ Ft. from N. Line

1020 Ft. from S. Line

1020 Ft. from E. Line

_____ Ft. from W. Line

FIRST REPORTS

Location ☒

Rig up _____

Drilling and Remarks:

RECORD

Cased _____ in., _____ ft.

Sand _____

Gas _____

Oil _____

Total Depth _____

PRODUCTION

1st 24 hrs. Nat. _____

1st 24 hrs. after shot _____

Gas _____ Cu. Ft.

Dry Hole _____

Abandoned _____

Date

MAR 3 1926

CHAS. L. SHERWOOD

192

Scout

Follenwood
 K16 KANSAS
 Map No. _____ Sec. *19* Twp. *25* R. *10*
 Well No. *Henley*
6 Well et 46 _____ Company

Contractor

COMPLETED

SECTION PLAT

			0

_____ Ft. from N. Line

1020 _____ Ft. from S. Line*1020* _____ Ft. from E. Line

_____ Ft. from W. Line

ABANDONED

Location _____

Rig up _____

Drilling and Remarks:

*Broken sand 1940-50**Top line 2077'**1st Break 2111'**D & W**2152' AFH*

RECORD

Cased _____ in., _____ ft.

Sand _____

Gas _____

Oil _____

Total Depth *2152'*

PRODUCTION

1st 24 hrs. Nat. _____

1st 24 hrs. after shot _____

Gas _____ Cu. Ft.

Dry Hole ☒Abandoned ☒

Date

JUN 9 1926

CHAS. L. SHERWOOD

192

Scout