

Well No. Robert Farm 2

Well No. 110 Hubert Farm
Hadden-McCullough Company

WEST

EAST

SOUTH

Rig Up_____

Drilling Remarks

PRODUCTION

1st 24 hrs. Nat. _____

1st 24 hrs. after shot_____


Gas _____ cu. ft.

Dry Hole

Abandoned -----

Map No. 15 Ans. Sec. 22 Twp. 25 R. 10Well No. 1 Libert FarmHadden & McCullough Company

NORTH

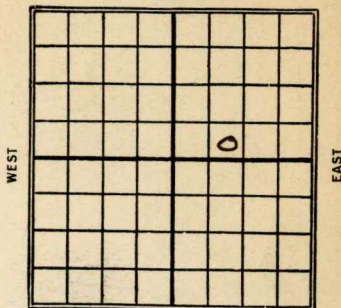

Ft. from N. Line

330 Ft. from S. Line

Ft. from E. Line

990 Ft. from W. Line

SOUTH

1926

Date

REPORT

9/22	Location
9/29	same
10/3	same
10/27	Rigging up
11/11	Drlg 600'
11/17	" 790
11/23	" 1200'
12/8	show oil at 1680'
	S.D. to run casing
12/15	Drlg 1740'
12/22	J.L. 2110' D.O.A. 2120'
	H.F.W.

Map No. **16 KANSAS** Sec. **22** Twp. **25** R. **10**
 Well No. **1** **Dikert**
Hadden & McCullough Company

Contractor

FIRST REPORTS

Ft. from N. Line

330

Ft. from S. Line

Ft. from E. Line

990

Ft. from W. Line

SECTION PLAT

Location ☒

Rig up

Drilling and Remarks:

RECORD

Cased _____ in., _____ ft.

Sand _____

Gas _____

Oil _____

Total Depth _____

PRODUCTION

1st 24 hrs. Nat. _____

1st 24 hrs. after shot _____

Gas _____ Cu. Ft.

Dry Hole _____

Abandoned _____

Date

SEP 22 1926**CHAS. L. SHERWOOD****192**

Scout

16 **KANSAS** *Shenwood*
 Map No. _____ Sec. *22* Twp. *25* R. *10*
 Well No. *1* *Sibert*
Hadden & McCullough Company

Contractor _____

COMPLETED

SECTION PLAT

_____ Ft. from N. Line

330

_____ Ft. from S. Line

_____ Ft. from E. Line

990

_____ Ft. from W. Line

ABANDONED

Location _____

Rig up _____

Drilling and Remarks:

*+ L 2110**DRG**2120**IFW*

RECORD

Cased _____ in., _____ ft.

Sand _____

Gas _____

Oil _____

Total Depth *2120*

PRODUCTION

1st 24 hrs. Nat. _____

1st 24 hrs. after shot _____

Gas _____ Cu. Ft.

Dry Hole ☒Abandoned ☒

Date

DEC 22 1926**CHAS. L. SHERWOOD***192*

Scout