

O. W. P. B.


KANSAS

Barton

Section 24 Township 20 Range 15W

Well No. #1 ~~Brandenberg~~ Radenberg

Company Magnolia
Uruh Pool

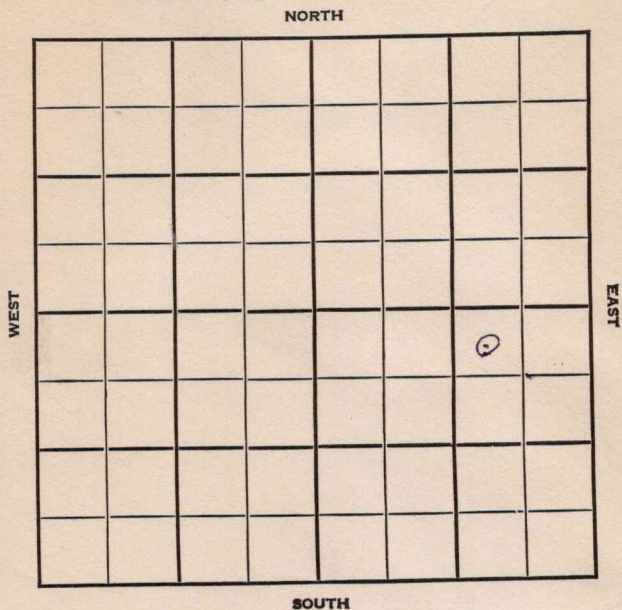

Sec. 24 Twp. 20 R. 15W

Well No. #1 Brandenburg Ladenberg Farm
Magnolia Company

Uruh

O. W. P. B.


330 Ft. from N. Line

Ft. from S. Line

990 Ft. from E. Line

Ft. from W. Line

NW NE SE

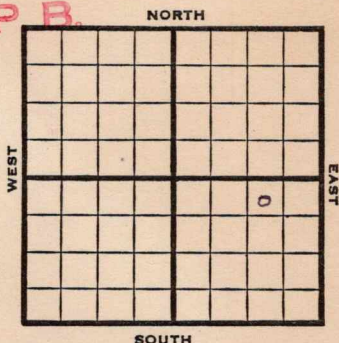

1948

Elev. 1913' REPORT

4/7 Location

4/14 "

4/21 8" @ 190'
Drlg. 950'

4/28 Drlg. 3085'

5/5 Lansing 3315'
Arbuckle 3593'
TD 3641'
5" @ 3636'
RUST

5/12 Flow 20 bbls oil PH

5/19 Arbuckle 3593'
5" @ 3636'
Bomb Pot. 1238 oil
Gr. 38°
TD 3641'

COMPLETED

O. W. P. B.

1951

6/13 KC 3315 Arb. 3598' OTD 3645
5" @ 3636 PB 3455 48/3442-52
8 goph 1000 A S/2 BOPH plus 6% AW
2000 A S/80 BO plus 12 BW in 12 hrs
S.P. 3350 30/3338-48 N/S 1000 A
Test wtr Sq off S.P. 3334
36/3322-34 1000A test Whr. Sq off CO
3455 P 15 BO plus 15 BWPD

FIRST REPORT & COMPLETE

Map No. _____ Sec. 24 Twp. 20 R. 15W

Well No. 1 Brandenburg

Magnolia Company

FIRST REPORT

Contractor

NW NE SE


SECTION PLAT

330 Ft. from N. Line

_____ Ft. from S. Line

990 Ft. from E. Line

_____ Ft. from W. Line

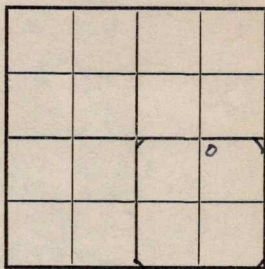

Barton County

Location X

Rig up _____

Drilling and Remarks:

RECORD

Cased _____ in., _____ ft.

Sand _____

Gas _____

Oil _____

Total Depth _____

PRODUCTION

1st 24 hrs. Nat. _____

1st 24 hrs. after shot _____

Gas _____ Cu. Ft.

Dry Hole _____

Abandoned _____

Date

APR 7 1948 19 S. J. LEWIS Scout

Map No. 82 Sec. 24 Twp. 20 R. 15W

Well No. 1 Radenberg

Magnolia

Company

CORRECTION

Contractor

NW NE SE


SECTION PLAT

330 Ft. from N. Line

_____ Ft. from S. Line

990 Ft. from E. Line

_____ Ft. from W. Line

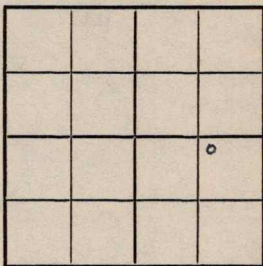

Barton County

Location _____

Rig up _____

Drilling and Remarks:

Reported

#1 Brandenburg

RECORD

Cased _____ in., _____ ft.

Sand _____

Gas _____

Oil _____

Total Depth _____

PRODUCTION

1st 24 hrs. Nat. _____

1st 24 hrs. after shot _____

Gas _____ Cu. Ft.

Dry Hole _____

Abandoned _____

Date

APR 14 1948 19

S. J. LEWIS Scout

Map No. 82 Sec. 24 Twp. 20 R. 15W

Well No. 1 Radenberg

Magnolia

Company

COMPLETE

Contractor

NW NE SE

E1/913
SECTION PLAT

330 Ft. from N. Line

Ft. from S. Line

990 Ft. from E. Line

Ft. from W. Line

			0

Barton County

Location

Rig up

Drilling and Remarks:

Per 8593

5.03636

Born 8/24/23 Toel

38-2

RECORD

Cased in., ft.

Sand

Gas

Oil ✓

Total Depth 2641

PRODUCTION

1st 24 hrs. Nat.

1st 24 hrs. after shot

Gas Cu. Ft.

Dry Hole

Abandoned

Date

MAY 19 1948

19

S. J. LEWIS

Scout

County Barton State Kansas
 Sec. 24 (Blk.) 20 (Sur.) 15W Map No.

Operator Magnolia

Well No. 1 Farm M. Radenberg

Elev. Location NW NE SE

FIRST REPORT
COMPLETE

330 Ft. From N Line SE

990 Ft. From E Line Quarter

1st. Report JUN 13 1951

Completion JUN 13 1951

Remarks

Spudding Date OW P.B.

Drlg. Data

K.C. 3315 Arb. 3598 O.T.D. 3645

5" @ 3636 P.B. 3455 48/3442-52

8 Goph. 1000A S/2 BOPH plus 6% AW

2000A S/80 BO plus 12 BW in 12 Hrs.

S.P. 3350 30/3338-48 N/S

1000A test Wtr. Sq off S.P. 3334

36/3322-34 1000A test Wtr. Sq off CO

to 3455 P 15 BO plus 15 BW PD.

Complete

J. E. TYRA