

Day 10

Map No. _____ Sec. 25 Twp. 25 R. 10

Well No. 1 - Brookover _____ Farm

Foster Oil

Company

NORTH

WEST

EAST

SOUTH

Location Tickets

Rig Up _____

Drilling Remarks:

Drilling Remarks:

RECORD

Cased _____ in. _____ ft.

Sand _____

Gas _____

Oil _____

Total Depth _____

PRODUCTION

1st 24 hrs. Nat. _____

1st 24 hrs. after shot _____

Gas _____ cu. ft

Dry Hole ☒

Abandoned 2220

Map No. _____ Sec. 25 Twp. 25 R. 10

Well No. 1 Brookover Farm

Foster Oil Company

NORTH

WEST

EAST

SOUTH

Location -----

Drilling Remarks:

Rig Up-----

Drilling Remarks:

RECORD

Cased_____ in_____Ft.

Sand -----

Gas _____

Oil _____

Total Depth_____

PRODUCTION

1st 24 hrs. Nat-----

1st 24 hrs. after shot-----

Gas-----Cu. Ft.

Dry Hole_____


Abandoned -----

Map No. 11/6 Sec. 25 Twp. 25 R. 10Well No. Brookover Farm
Foster O. Company

NORTH

WEST

EAST

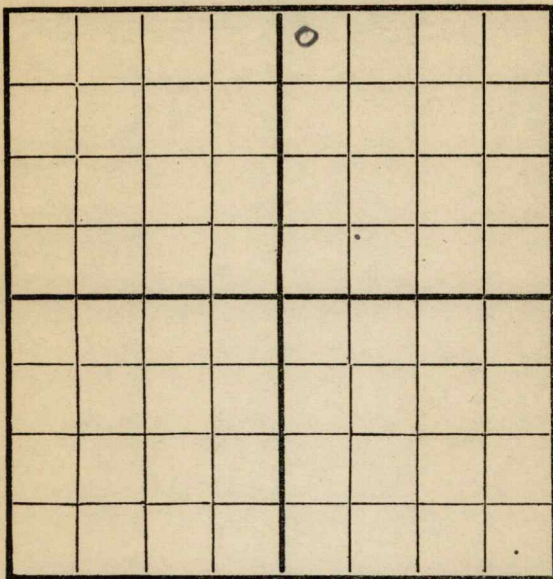

SOUTH

Location

Rig Up

Drilling and remarks

3/18/17 Spud in

RECORD

Cased in. Ft.

Sand

Gas

Oil

Total Depth

PRODUCTION

1st 24 hrs. Nat.

1st 24 hrs. after shot

Gas Cu. Ft.

Dry Hole

Abandoned

Date


3/24, 1917 Edw. L. Gast Scout

Map No. _____ Sec. 25, Twp. 25, R. 10Well No. BrookoverFoster Oil Company

NORTH

WEST

EAST

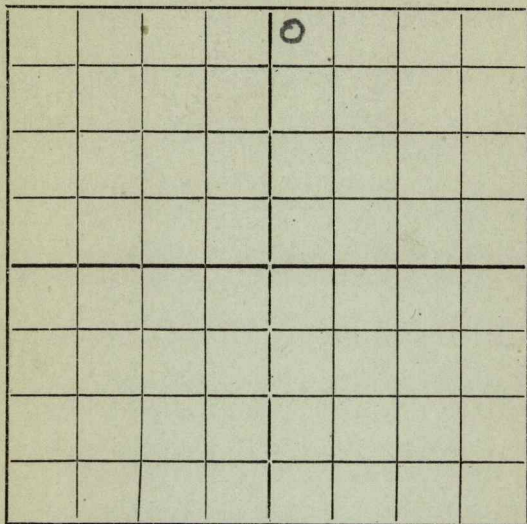

SOUTH

Location _____

Rig up _____

Drilling and remarks:

3/26 - 550'
Casing over since
4/5 - Set 506' - 12 1/2"
Casing

RECORD

Cased _____ in., _____ Ft.

Sand _____

Gas _____

Oil _____

Total Depth _____

PRODUCTION

1st 24 hrs. Nat. _____

1st 24 hrs. after shot _____

Gas _____ Cu. ft.

Dry Hole _____


Abandoned _____

Date

4/5 1917 Edw L. Gast Scout

*Greenwood*Map No. _____ Sec. *25* Twp. *25* R. *10*Well No. *1 Brookover* Farm*Foster Oil.* Company

NORTH

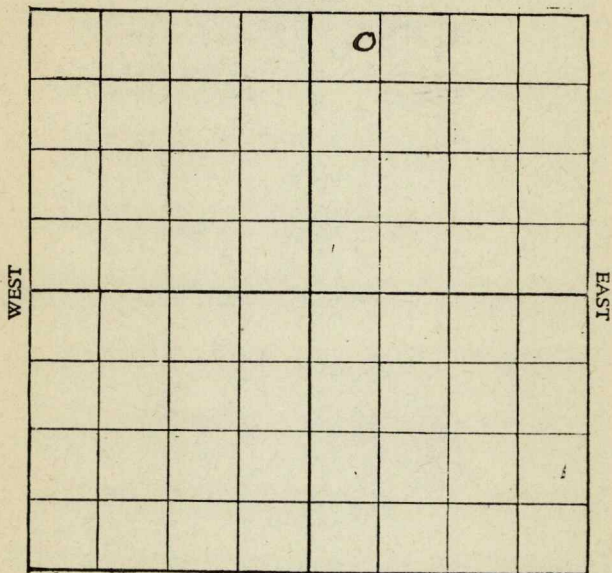

SOUTH

Location _____

Rig up _____

Drilling and remarks:

Dry. 2110'

RECORD

Cased _____ in. _____ Ft.

Sand _____

Gas _____

Oil _____

Total Depth _____

PRODUCTION

1st 24 hrs. Nat. _____

1st 24 hrs. after shot _____

Gas _____ Cu. Ft.

Dry Hole _____

Abandoned _____


Date

5/12, 191*7*, *Brocker* Scout

Greenwood

Map No. _____ Sec. 25 Twp. 25 R. 10Well No. 1 Brookover FarmFoster Oil Company

NORTH

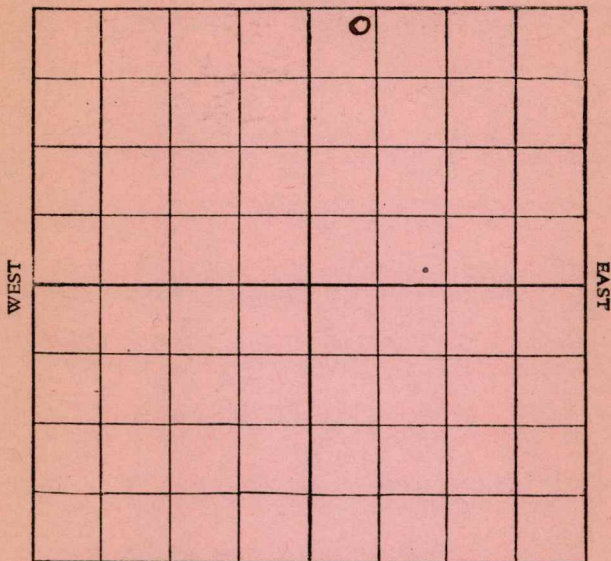

SOUTH

Location _____

Rig up _____

Drilling and remarks:

2215'Set. 6 5/8" Case

RECORD

Cased _____ in. _____ Ft.

Sand _____

Gas _____

Oil _____

Total Depth _____

PRODUCTION

1st 24 hrs. Nat. _____

1st 24 hrs. after shot _____

Gas _____ Cu. Ft.

Dry Hole _____

Abandoned _____

Date

5/19, 1917, Brookover Scout


Greenwood

Map No. *K-16* Sec. *25* Twp. *25* R. *10*

Well No. *1 Brookover* Farm

Foster Oil Company

NORTH

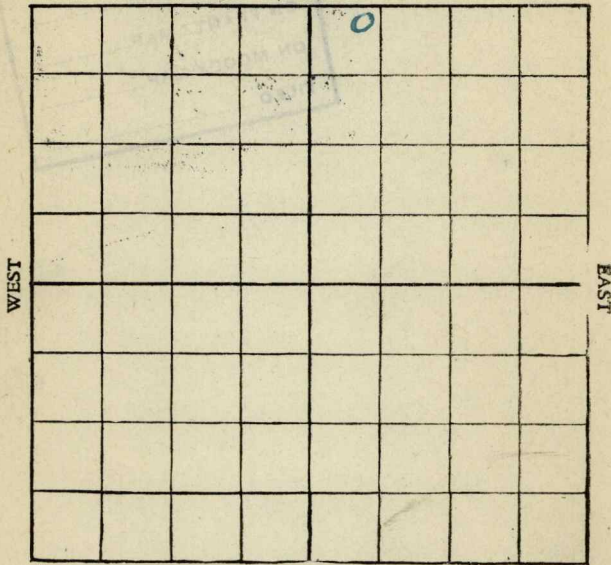

SOUTH

Location -----

Rig up -----

Drilling and remarks:

*Dry and
Abandoned
2215*

RECORD

Cased ----- in. ----- Ft.

Sand -----

Gas -----

Oil -----

Total Depth -----

PRODUCTION

1st 24 hrs. Nat. -----

1st 24 hrs. after shot -----

Gas ----- Cu. Ft.

Dry Hole ☒ -----

Abandoned ☒ *2215* -----

Date

5/26, 191*7*, *Brocker* Scout