

Barton County

Section 24 Township 20 Range 15WWell No. 1 SmithCompany Woodriver O & G

NORTH

			6				

WEST

EAST

SOUTH

KANSAS

Barton

Sec. 24 Twp. 20 R. 15W

Well No. #1 Smith Farm

Woodriver Oil & Ref. Company

Ash Creek


330 Ft. from N. Line

 Ft. from S. Line

330 Ft. from E. Line

 Ft. from W. Line

NORTH

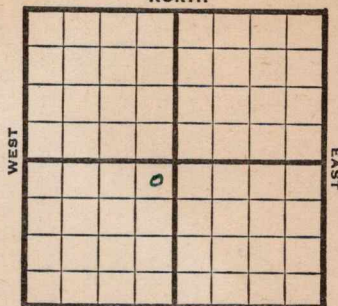

SOUTH

1947 **Elev. 1921'** REPORT

12/30 Drlg. 1500'

1948 10" @ 917'

1/7 **Lansing 3322'**

Arbuckle 3614'-52' TD

5" @ 3652'

RUST

1/14 TD 3653'

Fluid 1000' 20% W

1/21 TD 3653'

Swb 75 bbls oil / 160 W in 24 hrs.

1/26 "

2/4 "

2/11 "

2/18 "

2/25 "

3/3 **Arbuckle 3614'**

5" @ 3652'

Pump 32 oil / 50% W Pot.

Gr. 390

Total Depth 3653'

COMPLETED

Map No. _____ Sec. 24 Twp. 20 R. 15W

Well No. 1 Smith

Woodriver Oil & Ref. Company

FIRST REPORT

Contractor

NE SW


SECTION PLAT

330 Ft. from N. Line

_____ Ft. from S. Line

330 Ft. from E. Line

_____ Ft. from W. Line

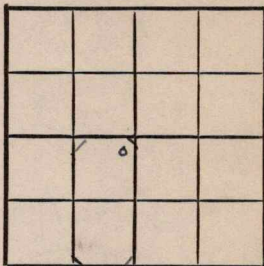

Barton County

Location _____

Rig up _____

Drilling and Remarks:

drlg. \$500

RECORD

Cased _____ in., _____ ft.

Sand _____

Gas _____

Oil _____

Total Depth _____

PRODUCTION

1st 24 hrs. Nat. _____

1st 24 hrs. after shot _____

Gas _____ Cu. Ft.

Dry Hole _____

Abandoned _____

Date

DEC 30 1947 19

S. J. LEWIS Scout

Map No. P2 Sec. 24 Twp. 20 R. 15W

Well No. 1 Smith

Woodriver Oil & Ref. Company

COMPLETE

Contractor

NE SW


E 11921
SECTION PLAT

330 Ft. from N. Line

_____ Ft. from S. Line

330 Ft. from E. Line

_____ Ft. from W. Line

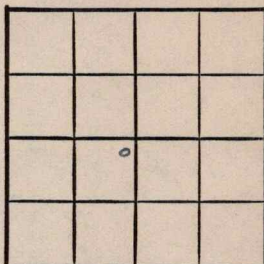

Barton County

Location _____

Rig up _____

Drilling and Remarks:

See 8614
5' @ 8652
Impress oil +
50% N.P.D.

39° E

RECORD

Cased _____ in., _____ ft.

Sand _____

Gas _____

Oil ✓

Total Depth 36.5

PRODUCTION

1st 24 hrs. Nat. _____

1st 24 hrs. after shot _____

Gas _____ Cu. Ft.

Dry Hole _____

Abandoned _____

Date

MAR 3 1948

19

S. J. LEWIS

Scout