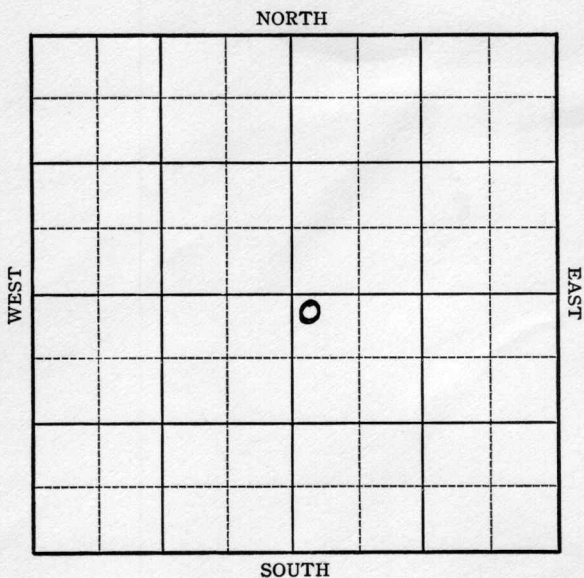


Section 17 Township 24 Range 13-EWell No. 1-EricksonCompany Anderson & Reed

1937

12/22 6" @ 1620'.

Miss. 1617'.

T.D. 1627'.

1000 acid.

Potential 60 bbls.

COMPLETED

Greenwood KANSAS

Map No. 17 Sec. 17 Twp. 24 R. 13EWell No. 1 EricksonAnderson & Reed

Company

Contractor

FIRST REPORT

SECTION PLAT

NW SE

250 Ft. from N. Line Ft. from S. Line Ft. from E. Line250 Ft. from W. Line

		0	

Location XRig up

Drilling and Remarks:

RECORD

Cased in., ft.Sand Gas Oil Total Depth

PRODUCTION

1st 24 hrs. Nat. 1st 24 hrs. after shot Gas Cu. Ft.Dry Hole Abandoned

Date

OCT - 6 1937

19

H. D. Hatfield

Scout

Greenwood **KANSAS**Map No. 17 Sec. 17 Twp. 24 R. 13EWell No. 1 EricksonAnderson & Reed

Company

Contractor

COMPLETED

NW SE

250 Ft. from N. Line

_____ Ft. from S. Line

_____ Ft. from E. Line

250 Ft. from W. Line**SECTION PLAT**

		0	

Location _____

Rig up _____

Drilling and Remarks:

*1000 acid**POT- 60***RECORD**Cased 6 in., 1620 ft.~~Sand~~ MISS 1617

Gas _____

Oil _____

Total Depth 1627**PRODUCTION**

1st 24 hrs. Nat. _____

1st 24 hrs. after shot _____

Gas _____ Cu. Ft.

Dry Hole _____

Abandoned _____

Date

DEC 22 1937 19H. D. Hatfield

Scout