


Greenwood

Form 51-5M-3-26-22544

Map No. *TAN* Sec. *27* Twp. *25* R. *10*

Well No. *1* *McCarthy* Farm
Bauman et al Company

NORTH

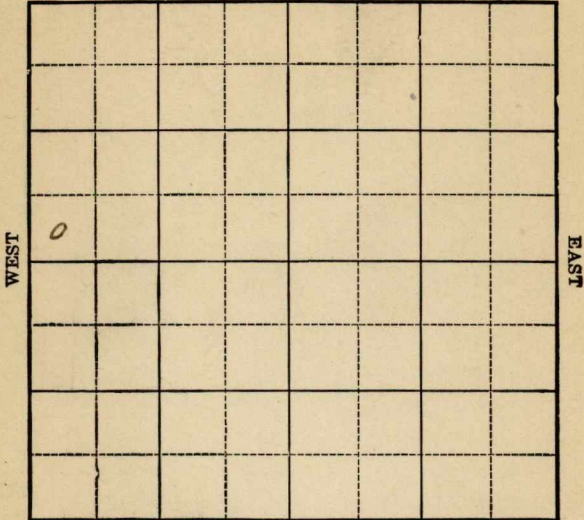

SOUTH

Location _____

Drilling Remarks _____

Rig Up _____

Drilling Remarks _____

RECORD

Cased _____ in. _____ ft.
Sand _____
Gas _____
Oil _____
Total Depth _____

PRODUCTION

1st 24 hrs. Nat. _____
1st 24 hrs. after shot _____
Gas _____ cu. ft.
Dry Hole _____
Abandoned _____

Greenwood

Map No. 17N Sec. 27 Twp. 25 R. 10Well No. 1-McCarthy Farm
Basum et al Company

NORTH


Ft. from N. Line

330 Ft. from S. Line

Ft. from E. Line

330 Ft. from W. Line

WEST

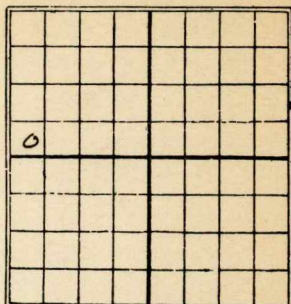

EAST

SOUTH

1926

Date

REPORT

8/25 Location

8-31

9/15

9/22 Bldg rig

9/29 rig

10/13 same

10/27 Drlg 540'

11/11 " 1410

11/17 S.D. 1775

11/23 Fishing casing 1775'

12/8 Drlg 2190'

12/15 S.D. 2190'

12/22 S.D. 2158' steel line meas.

12/30 Sdy skale. 1975-90

Top line 2085'

D & A. 2158'

S.L.M.

16 KANSAS

Map No. _____ Sec. 27 Twp. 25 R. 10

Well No. 1 Mc Carthy _____

Bassum et al _____ Company

_____ Contractor

FIRST REPORTS

SECTION PLAT

_____ Ft. from N. Line

320 _____ Ft. from S. Line

_____ Ft. from E. Line

330 _____ Ft. from W. Line

0			

Location ✓ _____

Rig up _____

Drilling and Remarks:

RECORD

Cased _____ in., _____ ft.

Sand _____

Gas _____

Oil _____

Total Depth _____

PRODUCTION

1st 24 hrs. Nat. _____

1st 24 hrs. after shot _____

Gas _____ Cu. Ft.

Dry Hole _____

Abandoned _____

Date

AUG 25 1926

CHAS. L. SHERWOOD

192

Scout

16 **KANSAS** Sec. 27 Typ. 25 R. 10
 Map No. _____
 Well No. 1 Mc Carthy
 Bason & al _____ Company
 _____ Contractor

COMPLETED**SECTION PLAT**

0			

_____ Ft. from N. Line

330 _____ Ft. from S. Line

_____ Ft. from E. Line

330 _____ Ft. from W. Line

ABANDONED

Location _____

Rig up _____

Drilling and Remarks:

Sdy line 1975-90
 Top line 2085
 DQ 2158
 S. L. M.

RECORD

Cased _____ in., _____ ft.

Sand _____

Gas _____

Oil _____

Total Depth 2158

PRODUCTION

1st 24 hrs. Nat. _____

1st 24 hrs. after shot _____

Gas _____ Cu. Ft.

Dry Hole ✓

Abandoned ✓

Date

DEC 30 1926

192

CHAS. L. SHERWOOD

Scout