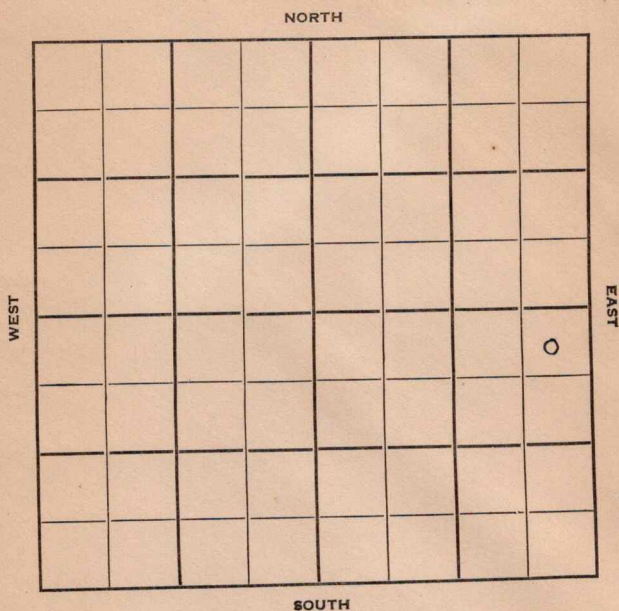


Section 27 Township 20 Range 15WWell No. #1 BowmanCompany Victor Drlg.

Barton

KANSAS

Sec. 27 Twp. 20 R. 15W

Well No. #1 Bowman Farm

Victor Drlg. Company

Contractor

Wildcat


330' Ft. from N. Line

Ft. from S. Line

330' Ft. from E. Line

Ft. from W. Line

NE NE SE

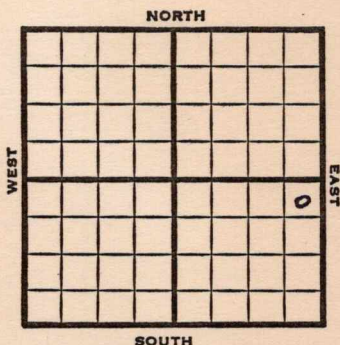

1951 Elev. 1936' REPORT

9/19 8" @ 812

1952
1/2

Oil well TD 3676' 8" @ 812'
 Anhy 900' Heeb 3254' Br. lime
 3352' Lans. 3368' Cong. 3607'
 Simp. 3620' Arb. 3662'
 DST 3664-76 open 1 hr. rec 70' O &
 GCM, 60' mud & oil, 300' free oil,
 35' sul. water 5" @ 3663'
 CO to 3676 S/5 BOPH S/3 $\frac{1}{4}$ BOPH
 3 hr. FU 2800' oil 48 hr.
 P/77 BF 12 hr. 40% water
 P/4 BFPB PB 3674' FU 2100' fluid
 40% water S/2 BO 1 BWPB
 12/3559-63 CO to 3664' S/22 BF
 6 hr. 40% water. P/86 BF 17 hr.
 70% water P/2 $\frac{1}{4}$ BFPB 70% water
 Comp. 7 BOPD & water.

COMPLETED

County Barton State Kansas

Sec. 27 (Blk.) 20 (Sur.) 15W Map No.

Operator Victor Drlg.

Well No. 1 Farm Bowman

Elev.	Location	NE	NE	SE
-------	----------	----	----	----

FIRST REPORT

330 Ft. From N Line SE

330 Ft. From E Line Quarter

1st. Report SEP 19 1951

Completion

Remarks Magnolia - F.O.

Spudding Date _____

Drlg. Data Wildcat

8 11 812

County Barton State KansasSec. 27 (Blk.
Twp.) 20 (Sur.
Rge.) 15W Map No.Operator Victor Drlg.Well No. 1 Farm BowmanElev. 1936 Location NE NE SE330 Ft. From N Line SE330 Ft. From E Line Quarter

1st. Report

Completion JAN 2 1952Remarks Wildcat

Spudding Date

Drlg. Data Oil well TD36768" @ 812 Anhy 900 Heeb. 3254Br. lime 3352 Lans. 3368 Cong. 3607Simp. 3620 Arb. 3662 DST 3664-76open 1 hr. Rec. 70' o & gcm 60' mud & oil300' free oil 35' sul. water 5" @ 3663CO to 3676 S/ 5 boph S/ 3 $\frac{1}{4}$ boph 3 hr.FU 2800' oil 48 hr. P/ 77 bf 12 hr.40% water P/ 4 bfph PB 3674FU 2100' fluid 40% water S/ 2 bo1 bwph 12/ 3559-63 CO to 3664 S/ 22 bf6 hr. 40% water P/ 86 bf 17 hr. 70% watP/ 2 $\frac{1}{4}$ bfph 70% water Comp. 7 bopd & wate

J. E. TYRA