


Barton KANSAS

Section 27 Township 20 Range 15 WWell No. # 2 BowmanCompany NCRA & Victor Drlg.

NORTH

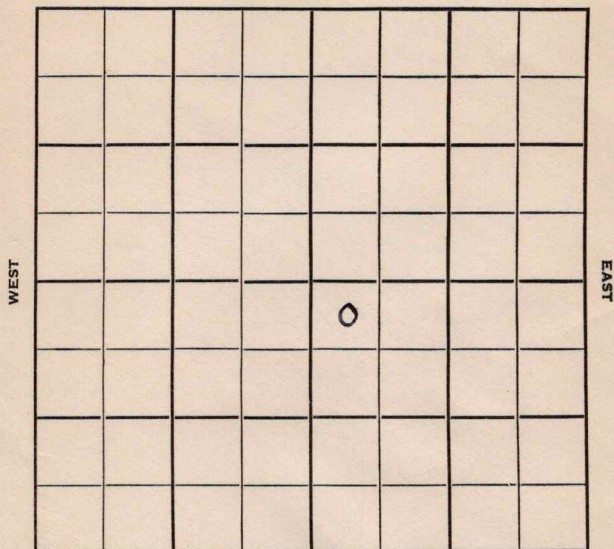

SOUTH

Barton

KANSAS

Sec. 27 Twp. 20 R. 15W

Well No. #2 Bowman Farm ☒

N.C.R.A. & Victor Drlg. Company

Victor- Contr. Contractor


330' Ft. from N. Line

 Ft. from S. Line

 Ft. from E. Line

330' Ft. from W. Line

NW NW SE

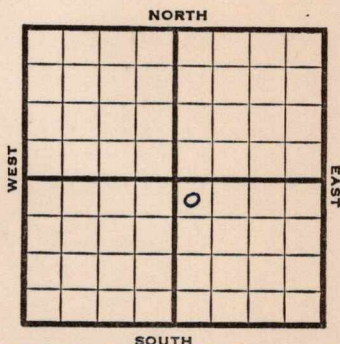

1952

Elev. 1944 REPORT

2/13

Location

2/20

"

3/5

Heeb. 3247 Br Li 3344

Lans. 3358 Cong. 3616

Simp 3628

Shut down 3652

3/12

Spud 2-22-52

D&A TD 3770

8" @ 924

Anhy 913 Heeb. 3247

Br lime 3344 Lans. 3358

Cong. 3616 Simp 3628

Arb. 3672

DST 3674-80 opn 1 $\frac{1}{4}$ hr.

Rec. 570' oil 50% wtr.

30' sul wtr & md TD 3770

ABANDONED

County Barton State Kansas

Sec. 27 (Blk.) 20 (Sur.) 15W Map No.

Operator N. C. R. A. & Victor Drlg.

Well No. 2 Farm Bowman

Elev.: Location NW NW ~~NW~~ SE

330 Ft. From N Line ~~NE~~ SE

330 Ft. From W Line Quarter

1st. Report **FEB 13 1952**

Completion

Remarks

Victor - Contr.

Spudding Date _____

Drig. Data

J. G. McGEHEE

County Barton State
 Sec. 27 (Blk.
Twp.) 20 (Sur.
Rge.) 15W Map No.

Operator NCRA & Victor Drlg.

Well No. 2 Farm Bowman

Elev. 1944 Location NW NW SE



330 Ft. From N Line SE

330 Ft. From W Line Quarter

1st. Report

Completion MAR 12 1952

Remarks

Victor - Contr.

Spudding Date 2-22-52

Drlg. Data D & A TD 3770

8" @ 924 Anhy 913 Heeb. 3247

Br. lime 3344 Lans. 3358 Cong. 3616

Simp. 3628 Arb. 3672 DST 3674-80

open 1 1/4 hr. Rec. 570' oil 30% water

30' sul. water & mud TD 3770

D & A