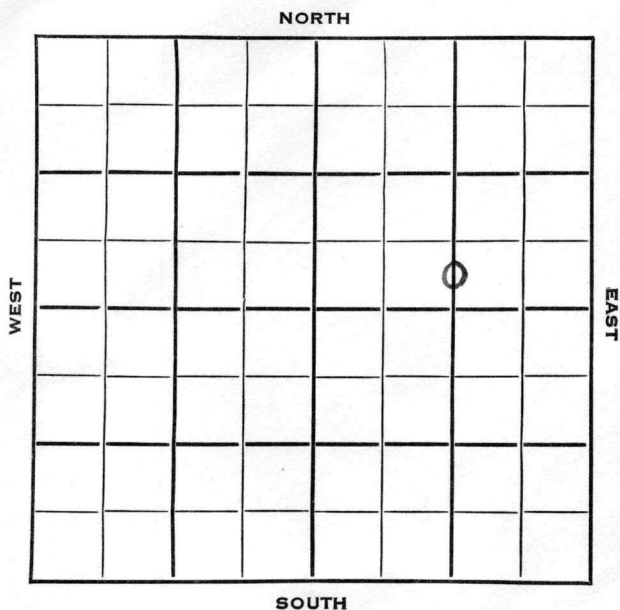


Section 35 Township 24 Range 12 EWell No. # 4 McKenzieCompany Moro Oil

Greenwood

KANSAS

SEC.	TWP.	R.
35.	24	12E

WELL NO.

4 McKenzie

FARM

COMPANY

Moro Oil

CONTRACTOR

Berentz

Ft. from N. Line

330


Ft. from S. Line

1320

Ft. from E. Line

Ft. from W. Line

C S/2 S/2 NE

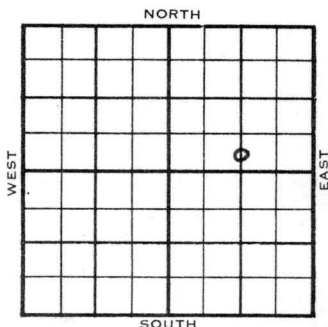

1953	ELEVATION	REPORT
	--	

10/21 Location

12/16 Spud 11-23-53

D&A

TD 1720'

10" @ 390'


8" @ 1160'

KC 868', Miss 1663'

TD 1720'

D&A

ABANDONED

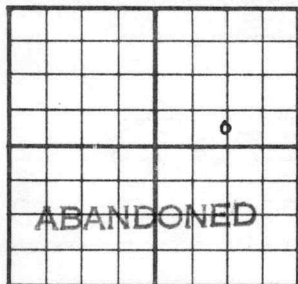County Greenwood State KANSASSec. 35 (Blk.
Twp.) 24 (Sur.
Rge.) 12E Map No. _____Operator Moro OilWell No. 4 Farm McKenzieElev. _____ Location C S $\frac{1}{2}$ S $\frac{1}{2}$ NE330 Ft. From S Line NE1320 Ft. From E Line Quarter

1st. Report _____

Completion DEC 16 1953

Remarks _____

Berentz - Contr.Spudding Date 11-23-53Drlg. Data D & A TD 172010" @ 390 8" @ 1160 KC 868Miss. 1663 TD 1720D & A

J. G. McGEHEE