

KANSAS


FORM 51 5M 1-42 PETROL

Greenwood

Section 34 Township 25 Range 9-E


Well No. #1 Lorecom

Company Slocom etal

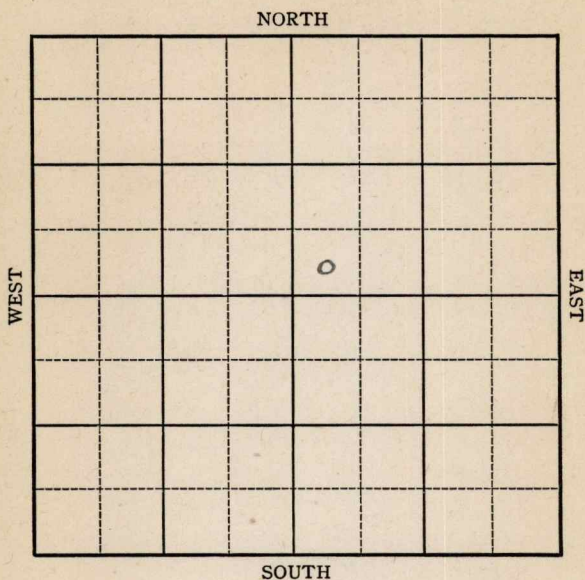

Sec. 34 **KANSAS** Twp. 25 R. 9-EWell No. #1 Larcom Farm
Slocom et al Company

NORTH

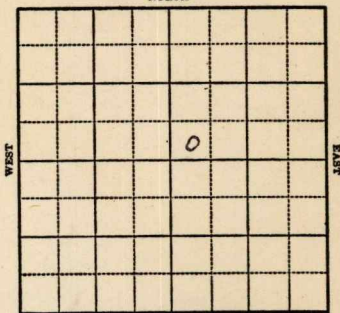

SOUTH

 Ft. from N. Line330 Ft. from S. Line Ft. from E. Line330 Ft. from W. Line

1944

R E P O R T

1-19	Machine
1/26	"
2/2	"
2/8	"
2/15	"
2/23	"
3/1	"
3/8	"
3/16	"
3/22	"
3/29	15" @ 14' TD 195 SD
4/5	" " "
4/12	Drlg. 315'
4/19	Drlg. 500'
4/26	SD for csg.

OVER

1944

5/3 SD for casing.

5/10 "

5/17 "

5/24 "

5/31 "

6/7 "

6/15 "

6/21 "

6/28 " " "

7/12 " " "

7/19 " " "

7/26 " " "

8/2 " " "

8/9 " " "

8/16 " " "

8/23 " " "

8/30 " " "

9/8 " " "

9/13 " " "

9/21 " " "

9/28 " " "

10/4 " " "

10/11 " " "

10/18 " " "

10/25 TD 567

ABANDONED

KANSAS

Map No. _____ Sec. 34 Twp. 25 R. 9EWell No. 1 Larcom

Slocum et al.

Company

FIRST REPORT

Contractor

SW NE

SECTION PLAT

		o	

_____ Ft. from N. Line

330 Ft. from S. Line

_____ Ft. from E. Line

330 Ft. from W. Line

Miscellaneous

Location _____

Rig up _____

Drilling and Remarks:

Machine

RECORD

Cased _____ in., _____ ft.

Sand _____

Gas _____

Oil _____

Total Depth _____

PRODUCTION

1st 24 hrs. Nat. _____

1st 24 hrs. after shot _____

Gas _____ Cu. Ft.

Dry Hole _____

Abandoned _____

Date

JAN 19 1944

19

S. J. LEWIS

Scout

Pool Name MiscellaneousMap No. 15 Sec. 34 Twp. 25 R. 9EWell No. 1 LarcomHolcomb CompanyABANDONED Contractor

SW NE

SECTION PLAT

		6	

 Ft. from N. Line330 Ft. from S. Line Ft. from E. Line330 Ft. from W. Line

Greenwood County

Location Rig up

Drilling and Remarks:

RECORD

Cased in., ft.Sand Gas Oil Total Depth 567

PRODUCTION

1st 24 hrs. Nat. 1st 24 hrs. after shot Gas Cu. Ft.Dry Hole Abandoned

Date

OCT 23 1944

19

S. J. LEWIS Scout