


Map No. _____ Sec. 36 Twp. 24 R. 12
Well No. 1- Hoover Farm _____
Chas. Christy Company _____

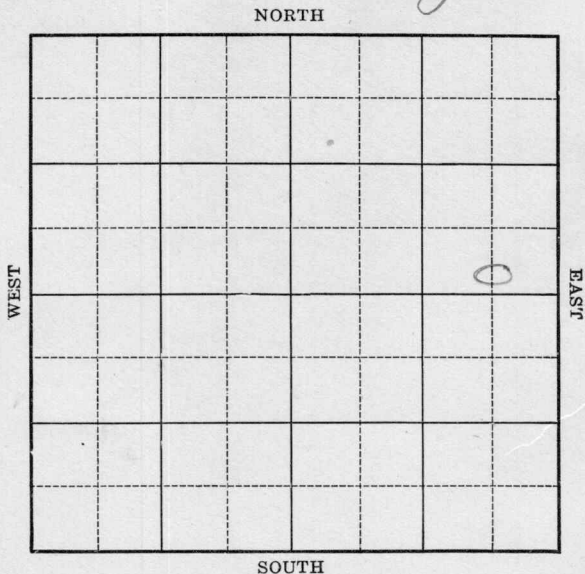

Location _____
Drilling Remarks _____

RECORD

Cased _____ in. _____ ft.
Sand _____
Gas _____
Oil _____
Total Depth _____

Rig Up _____
Drilling Remarks _____

PRODUCTION


1st 24 hrs. Nat. _____
1st 24 hrs. after shot _____
Gas _____ cu. ft.
Dry Hole _____
Abandoned _____

Map No. _____ Sec. 36 Twp. 24 R. 12Well No. 1-Hoover Farm
Chas. Christy Company

_____ Ft. from N. Line

220 Ft. from S. Line660 Ft. from E. Line

_____ Ft. from W. Line

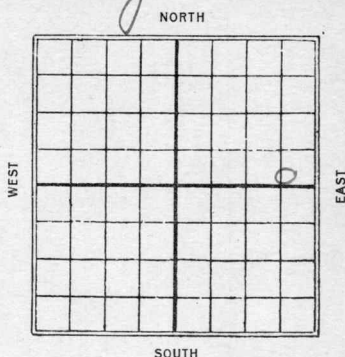1927

Date

REPORT

Date	REPORT
10/12	Location
10/19	Machine
10/27	Spudding
11/2	Drilg 420'
11/9	" 1100
11/16	" 1370
11/30	1593-1650 T.D. 1650
	Shale brk. 1616-25
	100/200 bbls

Sherwood ✓

16 KANSAS Map No. _____ Sec. 36 Twp. 24 R. 12

 Well No. Hoover
 Chas Christy Company
 Contractor

FIRST REPORTS

_____ Ft. from N. Line

220 _____ Ft. from S. Line

660 _____ Ft. from E. Line

_____ Ft. from W. Line

SECTION PLAT

			0

Location ✓ _____

Rig up _____

Drilling and Remarks:

RECORD

Cased _____ in., _____ ft.

Sand _____

Gas _____

Oil _____

Total Depth _____

PRODUCTION

1st 24 hrs. Nat. _____

1st 24 hrs. after shot _____

Gas _____ Cu. Ft.

Dry Hole _____

Abandoned _____

Date

OCT 12 1927

192

CHAS. L. SHERWOOD

Scout

Sherwood

16 KANSAS 36 Twp. 24 R. 12

Well No. 1 Hoover
Chas Christy

Company

Contractor

COMPLETED

SECTION PLAT

			o

Ft. from N. Line

220 Ft. from S. Line

660 Ft. from E. Line

Ft. from W. Line

Location

Rig up

Drilling and Remarks:

Shale Breaks 1616-25'

100' 200' Bls.

RECORD

Cased in., ft.

Sand 1593-1650

Gas

Oil

Total Depth 1650

PRODUCTION

1st 24 hrs. Nat.

1st 24 hrs. after shot

Gas Cu. Ft.

Dry Hole

Abandoned

Date

NOV 30 1927

CHAS. L. SHERWOOD

192

Scout