

KANSAS

Barton

O.W.D.D

Section 34 Township 20 Range 12WWell No. 2 FoelgnerCompany Camplin Ref.Workman
NORTH

			6				

WEST

EAST

SOUTH

O. W. D. D

KANSAS

Barton

Sec. 34 Twp. 20 R. 12W ✓

Well No. #2 Foelgner Farm

Champlin Ref.

Company

Workman Pool


NORTH

990' Ft. from N. Line

Ft. from S. Line

330' Ft. from E. Line

Ft. from W. Line

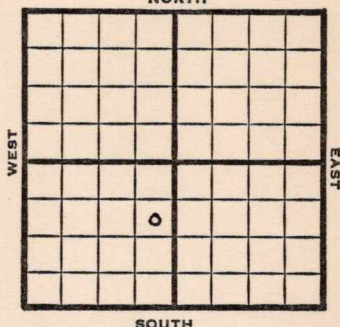

SE NE SW

1949

Elev 1841'

REPORT

5/18

Surface Hole

5/25

Lans. 3160'

Arb. 3393

Drlg 3396'

6/1

TD 3396'

5"@ 3393'

6/7

TD 3412

Swb 7 bbls oil PH 8 hrs.

6/15

"

6/21

"

6/28

"

7/6

"

7/13

TD 3412'

Arb. 3393'

5"@ 3393'

Pump 393 Oil Pot

39° Gr.

Comp

COMPLETED

O. W. D. D

1951

5/9

Arb. 3393

OTD 3412

DD 3418'

5/16

Oil well

TD 3429'

Arb. 3393'

OTD 3412'

DD 3429'

Comp. 45 BO

10 BWPD

COMPLETED

Map No. _____ Sec. 34 Twp. 20 R. 12W

Well No. 2 Foelgner

_____ Champlin Ref. _____ Company

_____ Contractor

SE NE SW


FIRST REPORT
SECTION PLAT

990 Ft. from N. Line

_____ Ft. from S. Line

830 Ft. from E. Line

_____ Ft. from W. Line

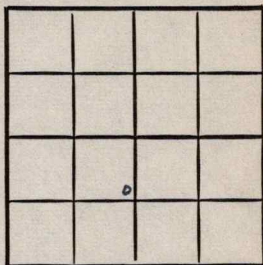

Barton County

Location _____

Rig up _____

Drilling and Remarks:

surface hole

RECORD

Cased _____ in., _____ ft.

Sand _____

Gas _____

Oil _____

Total Depth _____

PRODUCTION

1st 24 hrs. Nat. _____

1st 24 hrs. after shot _____

Gas _____ Cu. Ft.

Dry Hole _____

Abandoned _____

Date

MAY 18 1949

19

S. J. LEWIS

Scout

Map No. K 46 Sec. 34 Twp. 20 R. 12W

Well No. 2 Foelgner

Champlin Ref.

Company

COMPLETE

Contractor

SE NE SW


E 1, 1841
SECTION PLAT.

990 Ft. from N. Line

 Ft. from S. Line

330 Ft. from E. Line

 Ft. from W. Line

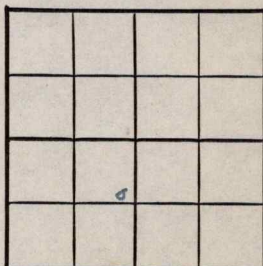

Barton County

Location

Rig up

Drilling and Remarks:

Cr 83393

5" 83393

Prod 893 oil 84

893 oil

RECORD

Cased in., ft.

Sand

Gas

Oil

Total Depth 84 1/2

PRODUCTION

1st 24 hrs. Nat.

1st 24 hrs. after shot

Gas Cu. Ft.

Dry Hole

Abandoned

Date

JUL 13 1949 19

S. J. LEWIS

Scout

County Barton State KansasSec. 34 (Blk. Twp.) 20 (Sur. Rge.) 12W Map No.Operator Champlin Ref.Well No. 2 Farm FoelgnerElev. Location SE NE SW

FIRST REPORT

0

990 Ft. From N Line SW330 Ft. From E Line Quarter1st. Report MAY 9 1951

Completion

Remarks OWDD

Spudding Date

Drlg. Data

Arb. 3393 OTD 3412 DD 3418

J. E. TYRA

County Barton State Kansas
 Sec. 34 (Blk.) 20 (Sur.) 12W Map No.
 Operator Champlin Ref.
 Well No. 2 Farm Foelgner
 Elev. Location SE ~~N~~ E SW



990 Ft. From N Line SW
330 Ft. From E Line Quarter

1st. Report

Completion MAY 14 1951

Remarks OWDD

O. W. D. D.

Spudding Date

Drlg. Data Oil well TD 3429

Arb. 3393 OTD 3412 DD 3429

Comp. 45 bo 10 bwpd

J. E. TYRA