


Section 36 Township 24 Range 12-EWell No. 2 KingCompany C. W. Cross

NORTH Miscellaneous

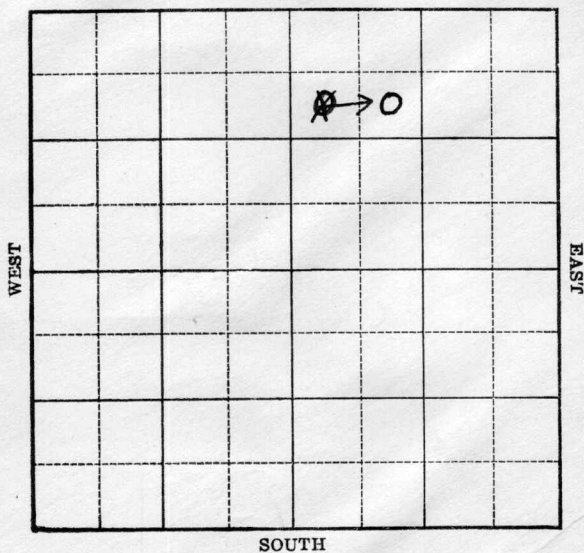

Greenwood **KANSAS**Map No. 16 Sec. 36 Twp. 24 R. 12EWell No. 2 KingC. W. Cross Company

Contractor

FIRST REPORT

SW NW NE

SECTION PLAT990 Ft. from N. Line Ft. from S. Line Ft. from E. Line330 Ft. from W. Line

		0	

MISCELLANEOUSLocation Rig up

Drilling and Remarks:

MACH.**RECORD**Cased in., ft.Sand Gas Oil Total Depth **PRODUCTION**1st 24 hrs. Nat. 1st 24 hrs. after shot Gas Cu. Ft.Dry Hole Abandoned

Date

JAN 11 1937 19H. D. Hatfield Scout

Greenwood KANSAS

Map No. 16 Sec. 36 Twp. 24 R. 12 ^EWell No. 2-KingC. W. Cross Company

Contractor

SE NW NE

CORRECTION

SECTION PLAT

		50	

990 Ft. from N. Line

_____ Ft. from S. Line

_____ Ft. from E. Line

990 Ft. from W. Line

CORRECTION

Location _____

Rig up _____

Drilling and Remarks:

Loc. correctedFromSWNW NE ToSE NW NE

RECORD

Cased _____ in., _____ ft.

Sand _____

Gas _____

Oil _____

Total Depth _____

PRODUCTION

1st 24 hrs. Nat. _____

1st 24 hrs. after shot _____

Gas _____ Cu. Ft.

Dry Hole _____

Abandoned _____

Date

MAR 8 - 1939 19

H. D. Hatfield

Scout

Greenwood KANSAS

Map No. 16 Sec. 36 Twp. 24 R. 12EWell No. 2 KingC. W. Cross

Company

Contractor

COMPLETED

SE NW NE

990 Ft. from N. Line Ft. from S. Line Ft. from E. Line990 Ft. from W. Line

SECTION PLAT

		0	

MISCELLANEOUS

RECORD

Location Cased 6 in., 1595 ft.Rig up Sand Bart 1605

Drilling and Remarks:

Gas Oil S.O. & 1/2 M. gas Total Depth 1660

PRODUCTION

1st 24 hrs. Nat. 1st 24 hrs. after shot Gas Cu. Ft.Dry Hole Abandoned

Date

MAR 22 1939 19H. D. Hatfield Scout