


Map No. _____ Sec. 36 Twp. 24 R. 12
Well No 2-Mary Farm _____
Chas Crockett Company

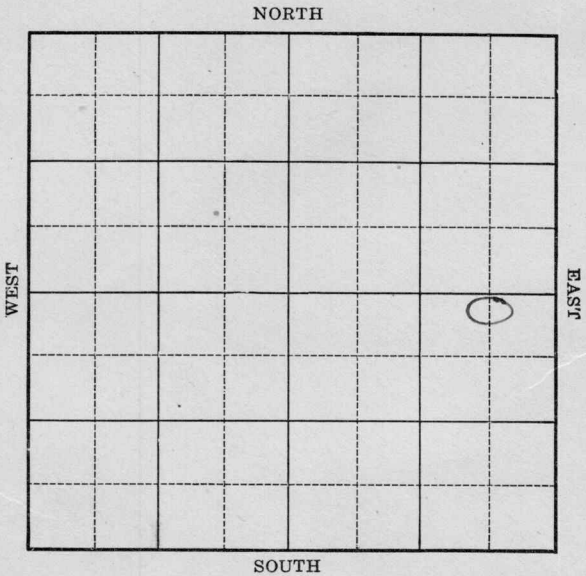

Location _____
Drilling Remarks _____

Rig Up _____
Drilling Remarks _____

RECORD


Cased _____ in. _____ ft.
Sand _____
Gas _____
Oil _____
Total Depth _____

PRODUCTION

1st 24 hrs. Nat. _____
1st 24 hrs. after shot _____
Gas _____ cu. ft.
Dry Hole _____
Abandoned _____

Map No. _____ Sec. 36 Twp. 24 R. 12Well No. 2 - May Farm _____
Chas. Crosscutak Company225 Ft. from N. Line~~7320~~ Ft. from S. Line660
~~330~~ Ft. from E. Line

_____ Ft. from W. Line

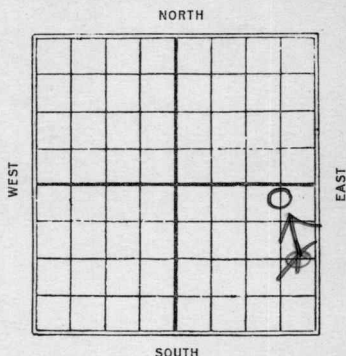1927

Date

REPORT

8/24 machine9/1 Well 1150'9/7 Sandy shale 1557-72 - sand
1572-1631 - T.D. 1634-300'
natural, will shoot 120 qts.9/14 1572-1631 T.D. 1634
120/160 bbb

K16 KANSAS

Map No. _____ Sec. 36 Twp. 24 R. 12Well No. 2 MayChas Cross et al Company

Contractor

FIRST REPORTS

_____ Ft. from N. Line

1370 Ft. from S. Line330 Ft. from E. Line

_____ Ft. from W. Line

SECTION PLAT

Location _____

Rig up _____

Drilling and Remarks:

Machining

RECORD

Cased _____ in., _____ ft.

Sand _____

Gas _____

Oil _____

Total Depth _____

PRODUCTION

1st 24 hrs. Nat. _____

1st 24 hrs. after shot _____

Gas _____ Cu. Ft.

Dry Hole _____

Abandoned _____

Date

AUG 24 1927 CHAS. L. SHERWOOD

192

Scout

SHERWOOD

K16 KANSAS

Map No. _____ Sec. 36 Twp. 24 R. 12Well No. 2 May
Chas Cross et al Company

Contractor _____

SECTION PLAT


225 Ft. from N. Line

_____ Ft. from S. Line

660 Ft. from E. Line

_____ Ft. from W. Line

CORRECTION

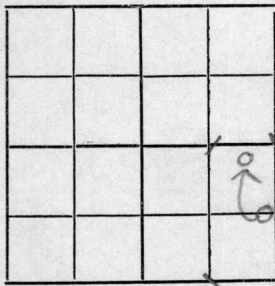

Location _____

Rig up _____

Drilling and Remarks:

chg 1150chg loc to above

RECORD

Cased _____ in., _____ ft.

Sand _____

Gas _____

Oil _____

Total Depth _____

PRODUCTION

1st 24 hrs. Nat. _____

1st 24 hrs. after shot _____

Gas _____ Cu. Ft.

Dry Hole _____

Abandoned _____

Date

SEP 1 - 1927

CHAS. L. SHERWOOD

192

Scout

16 KANSAS 36 Twp. 24 R. 12

Well No. 2 May
Chas Cross

Company

Contractor

COMPLETED

SECTION PLAT

			o

225 Ft. from N. Line

Ft. from S. Line

660 Ft. from E. Line

Ft. from W. Line

Location

Rig up

Drilling and Remarks:

RECORD

Cased in., ft.

Sand 1572-1631

Gas

Oil

Total Depth 1634

PRODUCTION

1st 24 hrs. Nat.

1st 24 hrs. after shot

Gas Cu. Ft.

Dry Hole

Abandoned

Date

SEP 14 1927

CHAS. L. SHERWOOD

192

Scout