


Section 3 Township 20 Range 13 W

Well No. # 2 Gaunt

Company W. L. Hartman

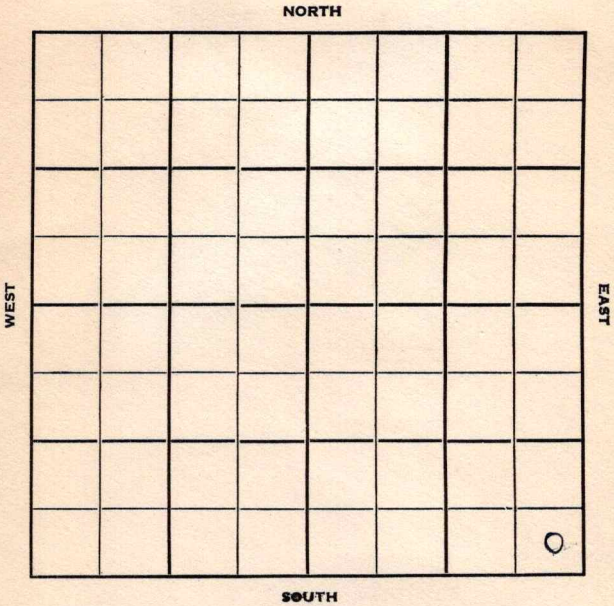

Barton

KANSAS

Sec. 3 Twp. 20 R. 13W

Well No. #2 Gaunt Farm

W. L. Hartman Company

Contractor

Wildcat


Ft. from N. Line

330' Ft. from S. Line

30' Ft. from E. Line

Ft. from W. Line

SE SE SE

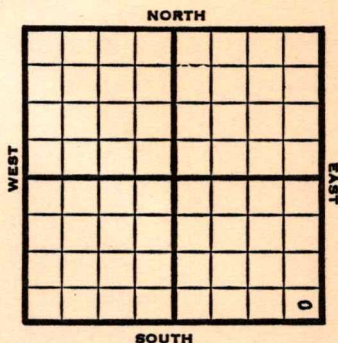

1951 **Elev. 1845'** REPORT

7/11

Spud 7-7-51

8" @ 185'

WOC

8/1

Spud 7-7-51

D&A TD 3477

8" @ 185

Anhy 689 Top. 2821

DST 3011-32 opn $\frac{1}{2}$ hr

Rec. 5' mud

Br Lime 3185 Lans. 3199

DST 3212-27 opn $\frac{1}{2}$ hr

Rec. 5' mud

DST 3251-59 opn $\frac{1}{2}$ hr Rec. 6'

mud DST 3259-70 opn $\frac{1}{2}$ hr

Rec. 12' mud

DST 3270-82 opn $\frac{1}{2}$ hr Rec. 10' mud

DST 3285-3302 opn 1 hr Rec. 10' mud

DST 3338-70 opn 1 hr Rec. 30' socm

DST 3370-90 opn 1 hr Rec. 5' mud

& SSO DS 3392-3406 opn 1 hr Rec.

3' mud DST 3406-22 opn 1 hr Rec.

5' mud **BKC 3421 Cong. 3425**

Arb. 3442

DST 3443-65 opn $\frac{1}{2}$ hr. Rec. 35' gcm

145' gas DST 3465-77 opn 1 hr

Rec. 30' so & gcm 160' gas

TD 3477 D&A

ABANDONED

J. E. TYRA

County Barton State Kansas
 Sec. 3 (Blk.) 20 (Sur.) 13W Map No.
 Operator W. L. Hartman
 Well No. 2 Farm Gaunt
 Elev. 1845 Location SE SE SE



330 Ft. From S Line SE
330 Ft. From E Line Quarter
 1st. Report
 Completion AUG 1 1951
 Remarks Wildcat

Spudding Date 7-7-51

Drlg. Data D & A TD 3477

8" @ 185 Anhy 689 Top. 2821 DST 3011-
32 open $\frac{1}{2}$ hr. Rec. 5' mud Br. lime 3185
Lans. 3199 DST 3212-27 open $\frac{1}{2}$ hr. Rec.
5' mud DST 3251-59 open $\frac{1}{2}$ hr. Rec. 6'
mud DST 3259-70 open $\frac{1}{2}$ hr. Rec. 12' mud
DST 3270-82 open $\frac{1}{2}$ hr. Rec. 10' mud
DST 3285-3302 open 1 hr. Rec. 10' mud
DST 3338-70 open 1 hr. Rec. 30' socm
DST 3370-90 open 1 hr. Rec. 5' mud & SSO
DST 3392-3406 open 1 hr. Rec. 3' mud
DST 3406-22 open 1 hr. Rec. 5' mud
B KC 3421 Cong. 3425 Arb. 3442
DST 3443-65 open $\frac{1}{2}$ hr. Rec. 35' gcm
145' gas DST 3465-77 open 1 hr.

J. E. TYRA

Drlg. Data

Rec. 30' so & gcm 160' gas TD 3477

D & A

_____	Misc.
_____	Pierce Map
_____	France Map
_____	Tracings
_____	Land Wall Map
_____	Land Small Map
_____	Scout Cards

1951 AUG 8

745476